

JACKSON MISSISSIPPI BOARD OF WATER COMMISSIONERS

G 31
9-1-62

WATER WELL DRILLERS LOG

Date: 9-1, 1962, Driller: George Colville County Jackson
30 (Name)

(1) Owner of Land: <u>Lee Pierce</u>	Description & Color of Materials Sand, Clay, Red Clay, Shell, etc.	Thick- ness Feet	Depth Feet
(Name) <u>Wade, Miss</u> (Address)	<u>Clay</u>	<u>12</u>	<u>12</u>
(2) Location: <u>SW 1/4, NW 1/4, Sec. 14 T28R6W</u> <u>3</u> miles <u>south</u> of <u>Wade</u> (distance) (direction) (Nearest Town)	<u>Coarse Sand</u>	<u>56</u>	<u>68</u>
(3) Topography: <u>Level</u> (Hilly) (Flat) (Level)			
(4) Purpose of Well: <u>Domestic</u> (Domestic Irrigation Municipal, Industrial, Other)			


Information upon completion of well:

- (1) Diameter 2 inches.
- (2) Total Depth 68 feet.
- (3) Water Level 40 feet below top of ground.
- (4) Cased to _____, Size _____.
- (5) Screen: Size 80gs, Length 5'.
- (6) Were any formations sealed against pollution?
_____ yes, no.

If YES depth of formation _____

Why _____

Drillers Remarks: _____

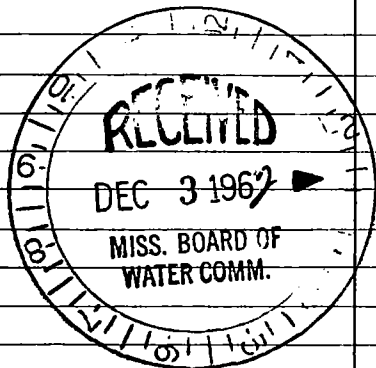

Well No. 177

(Use Back Side)

