

G 32

9-18-62

WATER WELL DRILLERS LOG

Date: 9/18, 1962, Driller: Flem Colville County Jackson

3 Q

(Name)

(1) Owner of Land: Tom Pierce
(Name)
Wade, Mira
(Address)

(2) Location: NE 1/4, SE 1/4, Sec. 15 T55R6W
4 miles South, of Wade
(distance) (direction) (Nearest Town)

(3) Topography: Hilly
(Hilly) (Flat) (Level)

(4) Purpose of Well: Domestic
(Domestic Irrigation
Municipal, Industrial, Other)

Description & Color of Materials Sand, Clay, Red Clay, Shell, etc.	Thick- ness Feet	Depth Feet
0-12 clay		
12-21 sand		
21-42 sand		
42-63 sand		
63-84 sand & shale		
84-105 shale		
105-126 sand		
126-147 clay		
147-267 clay		
267-273 sand		
273-379 clay		
379-483 streaks		
483-546 clay		
546-556 sand		
556-569 clay		
569-596 sand		
596-670 clay		
670-672 sand		
672-714 streaks		
714-756 clay		
756-769 sand		
TD		

Information upon completion of well:

(1) Diameter 1 1/2 inches.

(2) Total Depth 769 feet.

(3) Water Level + 25 feet below top of ground.

(4) Cased to _____, Size _____


(5) Screen: Size 1 1/4, Length 10

(6) Were any formations sealed against pollution?
_____ yes, X no.

If YES depth of formation _____

Why _____

Drillers Remarks: _____

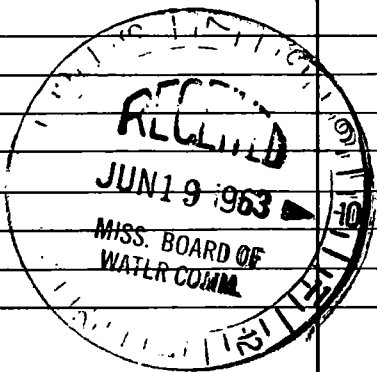

(Use Back Side)

Well No. 177

SECRET

Date	Description	Amount
1950-01-01	Initial deposit	1000.00
1950-02-15	Withdrawal	250.00
1950-03-10	Deposit	500.00
1950-04-20	Withdrawal	100.00
1950-05-01	Deposit	750.00
1950-06-15	Withdrawal	300.00
1950-07-10	Deposit	400.00
1950-08-25	Withdrawal	150.00
1950-09-01	Deposit	600.00
1950-10-15	Withdrawal	200.00
1950-11-10	Deposit	350.00
1950-12-20	Withdrawal	100.00
1951-01-01	Final balance	2500.00