

JACKSON

G 33

9-26-62

WATER WELL DRILLERS LOG

Date: 9-26, 1962, Driller: Flin Colville County: Jackson
 (Name)

(1) Owner of Land:	Description & Color of Materials Sand, Clay, Red Clay, Shell, etc.	Thick- ness Feet	Depth Feet
<u>Frank Ingram</u> (Name)	0-21 red clay		
<u>Wade</u> (Address)	21-42 red clay		
(2) Location: <u>NE 1/4, SE 1/4, Sec. 15 T55R6W</u>	42-63 sandy clay		
<u>3</u> miles <u>South</u> , of <u>Wade</u>	63-120 sand and gravel		
(distance) (direction) (Nearest Town)	120-395 clay		
(3) Topography: <u>Hilly</u>	395-399 Fine sand		
(Hilly) (Flat) (Level)	399-525 Clay & sand streaks		
(4) Purpose of Well: <u>Domestic</u>	525-542 sand		
(Domestic Irrigation Municipal, Industrial, Other)	542-546 streaks		

Information upon completion of well:

(1) Diameter 2 inches.

(2) Total Depth 808 feet.

(3) Water Level +25 feet below top of ground.

(4) Cased to _____, Size _____


(5) Screen: Size 2, Length 10'

(6) Were any formations sealed against pollution?
 _____ yes, X no.

If YES depth of formation _____

Why _____

Drillers Remarks: _____

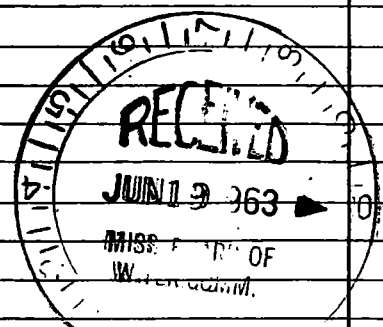

Well No. 179

(Use Back Side)

