

G 34

WATER WELL DRILLERS LOG

10-11-62

Date: Oct 11, 1962, Driller: Slim Colville County Jackson

34

(1) Owner of Land: Will Kirby Wade Miss

Description & Color of Materials Sand, Clay, Red Clay, Shell, etc.	Thick-ness Feet	Depth Feet
0-21 clay		
21-35 clay		
35-68 sand & gravel		
T.D.		

(2) Location: SE 1/4, NE 1/4, Sec. 10 T55R6W


(3) Topography: Hilly

(4) Purpose of Well: Domestic

Information upon completion of well:

(1) Diameter 2 inches. (2) Total Depth 68 feet. (3) Water Level 30 feet below top of ground. (4) Cased to Size. (5) Screen: Size 2 inches, Length 5 feet. (6) Were any formations sealed against pollution? yes, X no.

If YES depth of formation. Why. Drillers Remarks.

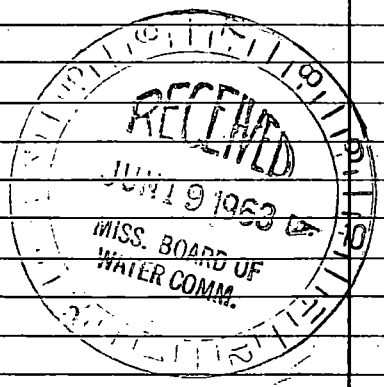

Well No. 142

(Use Back Side)

