

JACKSON

G 35

WATER WELL DRILLERS LOG

11-29-62

Date: Nov 29, 1962, Driller: George Colville County Jackson
(Name)

(1) Owner of Land: Edward Parker
(Name)
Wale Miss
(Address)

(2) Location: NE 1/4, NE 1/4, Sec. 35
(Address) T5 R6W
1/2 miles south, of Wale
(distance) (direction) (Nearest Town)

(3) Topography: Hilly
(Hilly) (Flat) (Level)

(4) Purpose of Well: Domestic
(Domestic Irrigation Municipal, Industrial, Other)

Description & Color of Materials Sand, Clay, Red Clay, Shell, etc.	Thick- ness Feet	Depth Feet
0-8 clay		
8-70 sand & gravel		
70-160 clay		
160-189 sand		
189-300 clay		
300-306 sand		
306-416 clay		
416-436 sand		
TD		

Information upon completion of well:

(1) Diameter 1 1/4 inches.

(2) Total Depth 436 feet.

(3) Water Level +10-6" feet below top of ground.

(4) Cased to _____, Size _____


(5) Screen: Size 1 1/4, Length 10'

(6) Were any formations sealed against pollution?
 _____ yes, X no.

If YES depth of formation _____

Why _____

Drillers Remarks: _____

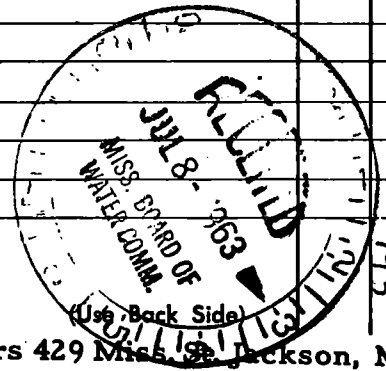

Well No. 195

WATER WELL PERMIT APPLICATION

Applicant Name: _____

(Name)

Depth of Formation	Formation Name	Thickness	Remarks
	Formation A		
	Formation B		
	Formation C		
	Formation D		
	Formation E		
	Formation F		
	Formation G		
	Formation H		
	Formation I		
	Formation J		
	Formation K		
	Formation L		
	Formation M		
	Formation N		
	Formation O		
	Formation P		
	Formation Q		
	Formation R		
	Formation S		
	Formation T		
	Formation U		
	Formation V		
	Formation W		
	Formation X		
	Formation Y		
	Formation Z		

Location of Well: _____

(Address)

City: _____

County: _____

State: _____

Business of Applicant: _____

Information on completion of well: _____

General notes: _____

_____ feet


_____ feet below top of _____

_____ size _____

_____ length _____

Were any formations sealed against pollution? _____

YES depth of formation _____

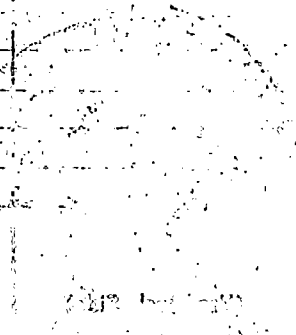

Scale: _____