

G 36

WATER WELL DRILLERS LOG

12-17-62

Date: Dec 17, 1962, Driller: Andrew Colville County Jackson

39

(Name)

(1) Owner of Land: Sue Carter

(Name)

Wade Miss

(Address)

(2) Location: SE 1/4, NW 1/4, Sec. 3 T45R64

1/4 miles west of Wade

(distance)

(direction)

(Nearest Town)

(3) Topography: hilly

(Hilly)

(Flat)

(Level)

(4) Purpose of Well: domestic

(Domestic Irrigation, Municipal, Industrial, Other)

Description & Color of Materials Sand, Clay, Red Clay, Shell, etc.

Thick-ness Feet

Depth Feet

0-18 clay

18-38 sand

38-42 clay

42-90 sand

90-170 clay

170-252 clay

252-294 Brittle clay

294-302 fine sand

302-472 clay

472-484 fine sand

484-489 clay

489-500 clay

500-502 clamshell

502-520 clay

520-538 sand

TD

Information upon completion of well:

(1) Diameter 1 1/4 inches.

(2) Total Depth 538 feet.

(3) Water Level + 18' feet below top of ground.

(4) Cased to _____, Size _____

(5) Screen: Size 1 1/4 Length 10'


(6) Were any formations sealed against pollution?

yes, X no.

If YES depth of formation _____

Why _____

Drillers Remarks: _____

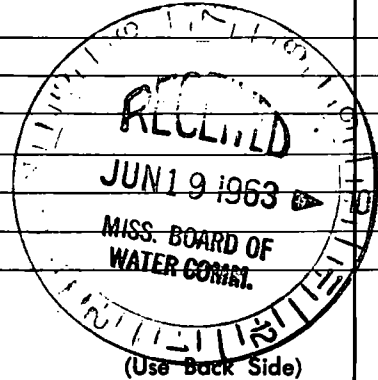

Well No. 184

