

JACKSON MISSISSIPPI BOARD OF WATER COMMISSIONERS

G 37

4-4-63

WATER WELL DRILLERS LOG

Date: April 4, 1963, Driller: George Colville County Jackson  
(Name)

(1) Owner of Land: Claude Vice  
(Name)  
Helena Miss  
(Address)

(2) Location: NE 1/4, NE 1/4, Sec 31 T5 R6W  
10 miles North, of Most Point  
(distance) (direction) (Nearest Town)

(3) Topography: \_\_\_\_\_  
(Hilly) (Flat) (Level)

(4) Purpose of Well: \_\_\_\_\_  
(Domestic Irrigation  
Municipal, Industrial, Other)

Description & Color of Materials Sand, Clay, Red Clay, Shell, etc.	Thick- ness Feet	Depth Feet
Sand		39
Clay	5	44
Sand	16	60
Clay	6	66
Sand & Gravel	26	92
Clay	62	154
Sand	45	199

Information upon completion of well:

(1) Diameter 1 1/4 inches.

(2) Total Depth 199 feet.

(3) Water Level 7 feet below top of ground.


(4) Cased to \_\_\_\_\_, Size \_\_\_\_\_.

(5) Screen: Size 1 1/4, Length 10'

(6) Were any formations sealed against pollution?  
 \_\_\_\_\_ yes,  no.

If YES depth of formation \_\_\_\_\_  
 Why \_\_\_\_\_

Drillers Remarks: \_\_\_\_\_  
 \_\_\_\_\_  
 \_\_\_\_\_

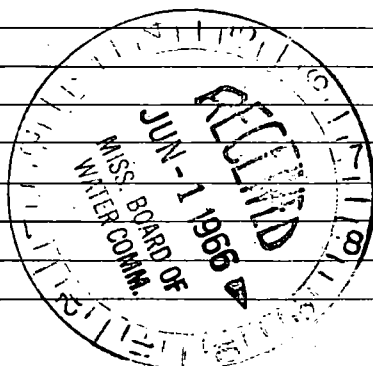

Well No.  
8209

(Use Back Side)

