

49

Jackson
G 38
4-63

MISSISSIPPI
BOARD OF WATER COMMISSIONERS
416 North State Street
Jackson, Mississippi 39201

WATER WELL DRILLERS LOG

April 9 1963 Colville Water Supply Co. Inc. Jackson
 date well completed firm name county well located

LANDOWNER: Harley Goff

Wade Miss
(mailing address)


WELL LOCATION:
 sec. 10 T. 5 N R. 6 E
 6 miles South of Wade
 (distance) (direction) (nearest town)

WELL PURPOSE: home
(home, irrigation, municipal, industrial)

WELL COMPLETION DATA:

- (1) diameter (inches) 1 1/4
- (2) total depth (feet) 577
- (3) static water level (feet) 4 1/2 below above top of ground.
- (4) casing _____ (material) _____ (depth) _____
 _____ (size) If telescope see back.
- (5) screen 5 _____ 572
 (length) (depth to top)
1/4 _____ Stainless Steel
 (size) (material)
- (6) pump _____ (HP) _____ (yield gpm)
 _____ (type power)
- (7) electric log NO
 (yes or no)
 _____ (organization running log)
- (8) how well bottom plugged BP Valve

description of formations encountered	from	to
Clay	0	16
sand	16	18
Clay	21	30
Sand	30	42
Red Gravel	42	63
Sand & Gravel	63	79
Clay	79	90
Sand & Gravel	90	105
Clay	105	124
Sand	124	126
Clay	126	197
FINE SAND	197	201
Clay	201	281
FINE SAND	291	294
Clay	294	334
FINE SAND	334	371
Streaks of Fine Sand & Clay	371	372
FINE SAND	372	400
Clay	400	410
FINE SAND	410	440
Clay with strks of fine sand	440	546
SAND	546	577

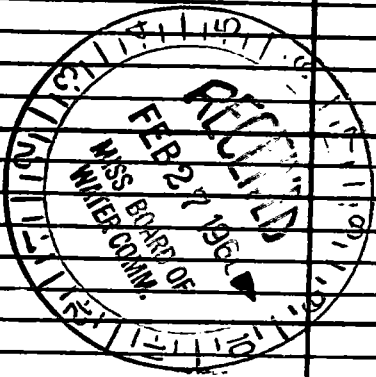

DRILLERS REMARKS:

