

Jackson

MISSISSIPPI BOARD OF WATER COMMISSIONERS

G-41
4-24-66

WATER WELL DRILLERS LOG

Date: APR 21, 1966, Driller: T.C. STORK (Colville) County Jackson
49


	Description & Color of Materials Sand, Clay, Red Clay, Shell, etc.	Thick- ness Foot	Depth Foot
(1) Owner of Land: <u>H. EDGAR GOFF</u> <small>(Name)</small>	<u>Clay</u>	<u>35</u>	<u>35</u>
<u>Wade, Miss.</u> <small>(Address)</small>		<u>33</u>	<u>68</u>
(2) Location: <u>SE 1/4, SE 1/4, Sec 3 T55R6W</u> <u>1</u> miles <u>S</u> of <u>Wade</u> <small>(distance) (direction) (Nearest Town)</small>			
(3) Topography: <u>Level</u> <small>(Hilly) (Flat) (Level)</small>			
(4) Purpose of Well: <u>Dom</u> <small>(Domestic Irrigation Municipal, Industrial, Other)</small>			

Information upon completion of well:

- (1) Diameter 2 inches.
- (2) Total Depth 69 feet.
- (3) Water Level 13 feet below top of ground.
- (4) Cased to 63, Size 2 in.
- (5) Screen: Size 2 in 1008, Length 5 ft
- (6) Were any formations sealed against pollution?
no

If YES depth of formation _____
Why _____

Drillers Remarks: _____

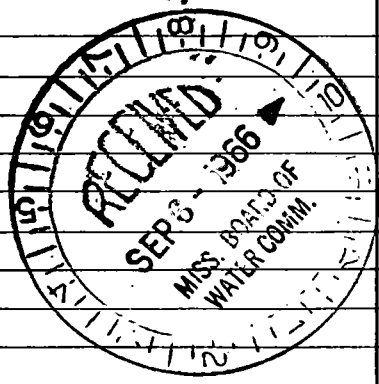

(Use Back Side)

Well No.

