

JACKSON MISSISSIPPI BOARD OF WATER COMMISSIONERS

G 42

4-24-66

WATER WELL DRILLERS LOG

Date: April 24, 1966, Driller: George Cowell County: Jackson
 49 (Name)

(1) Owner of Land: Glynn Davis
 (Name)
Wade, Mississippi
 (Address)

(2) Location: NE 1/4, SE 1/4, Sec. 11 T35R6W
1 1/2 miles South of Wade
 (distance) (direction) (Nearest Town)

(3) Topography: Level
 (Hilly) (Flat) (Level)

(4) Purpose of Well: Domestic
 (Domestic Irrigation
 Municipal, Industrial, Other)

Description & Color of Materials Sand, Clay, Red Clay, Shell, etc.	Thick- ness Feet	Depth Feet
<u>Clay</u>	<u>15</u>	<u>15</u>
<u>Sand</u>	<u>29</u>	<u>44</u>
<u>Gravel</u>	<u>35</u>	<u>79</u>
<u>Clay</u>	<u>258</u>	<u>337</u>
<u>Sand</u>	<u>56</u>	<u>393</u>

Information upon completion of well:

(1) Diameter 2 inches.

(2) Total Depth 393 feet.

(3) Water Level -2 feet below top of ground.

(4) Cased to 383, Size 2 in.


(5) Screen: Size 30 ga, Length 10 ft.

(6) Were any formations sealed against pollution?
 _____ yes, no.

If YES depth of formation _____

Why _____

Drillers Remarks: _____

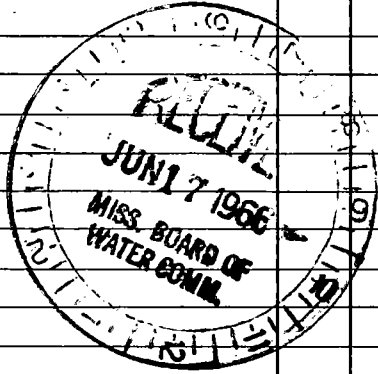

Well No. 915

(Use Back Side)

