

G 44

G-23-66

**WATER WELL DRILLERS LOG**

Date: June 23, 1966, Driller: J.P. STORK (Colville) County: Jackson  
 + P (Name)


(1) Owner of Land: Kenneth Bell  
 (Name)  
Wade, Miss.  
 (Address)  
 (2) Location: NW 1/4, SE 1/4, Sec. 36 T8S R6W  
8 miles S of Wade  
 (distance) (direction) (Nearest Town)  
 (3) Topography: FLAT  
 (Hilly) (Flat) (Level)  
 (4) Purpose of Well: Dom  
 (Domestic Irrigation  
 Municipal, Industrial, Other)

Description & Color of Materials Sand, Clay, Red Clay, Shell, etc.	Thick- ness Feet	Depth Feet
CLAY	18	18
SAND	70	88
CLAY	44	132
SAND	66	198
CLAY	88	286
SAND	16	302
CLAY	208	530
SAND	5	535
CLAY	185	720
SAND	28	748

Information upon completion of well:

(1) Diameter 1 1/2 inches.  
 (2) Total Depth 748 feet.  
 (3) Water Level +19-6 <sup>Above</sup> feet below top of ground.  
 (4) Cased to 738, Size 1 1/2  
 (5) Screen: Size 1 1/2 80 mesh, Length 10 ft.  
 (6) Were any formations sealed against pollution?  
 \_\_\_\_\_ yes,  no.

If YES depth of formation \_\_\_\_\_  
 Why \_\_\_\_\_  
 Drillers Remarks: \_\_\_\_\_

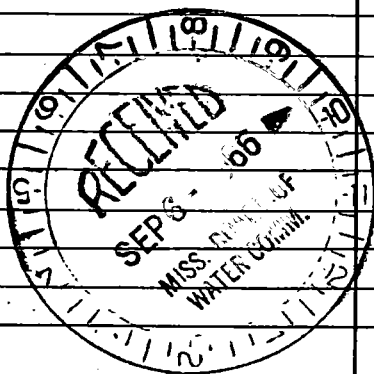

(Use Back Side)

Well No.

