

49

Jackson  
~~2-63~~ 646  
 2-63

MISSISSIPPI  
 BOARD OF WATER COMMISSIONERS  
 416 North State Street  
 Jackson, Mississippi 39201

WATER WELL DRILLERS LOG

Feb 20 19 63 Colville Water Supply Jackson  
 date well completed firm name county well located

LANDOWNER: J. L. Hayes

description of formations encountered from to

Wade, Miss.  
 (mailing address)

CLAY	0	21
SAND	21	41
CLAY	41	44
GRAVEL	44	55
CLAY	55	63
SAND & GRAVEL	63	83
CLAY	83	178
Rock (Limestone)	178	180
GRITTY CLAY	180	205
CLAY	205	300
CLAY shells	300	305
CLAY	305	325
SAND	325	336
CLAY	336	342
SAND	342	388

WELL LOCATION:


sec. 10 T. 5 N. R. 6 E.  
 2 miles S of Wade  
 (distance) (direction) (nearest town)

WELL PURPOSE: Home  
 (home, irrigation, municipal, industrial)

WELL COMPLETION DATA:


- (1) diameter (inches) 1 1/4
- (2) total depth (feet) 388
- (3) static water level (feet) 1  below  above top of ground.
- (4) casing pipe 368  
 (material) (depth)  
1 1/4 if telescope see back.  
 (size)
- (5) screen 10 368  
 (length) (depth to top)  
1 1/4 BRASS MESH  
 (size) (material)
- (6) pump — —  
 (HP) (yield gpm)  
Elec  
 (type power)
- (7) electric log NO  
 (yes or no)
- (organization running log)
- (8) how well bottom plugged BR Value

DRILLERS REMARKS:

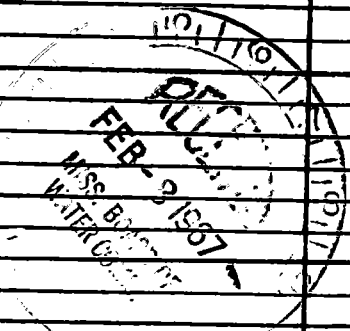

If well telescopes please sketch and show depths.

GROUND LEVEL

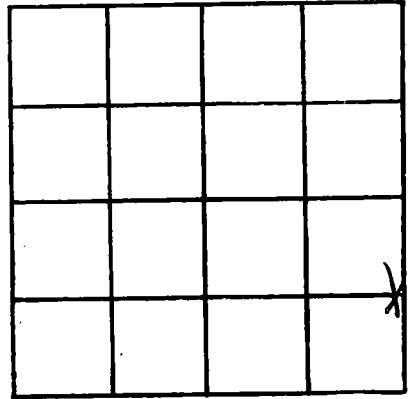

SECTION 10

Please indicate well location X.

ADDITIONAL INFORMATION

If more than one screen, show locations of each on sketch.