

JACKSON
G 48
7-64

MISSISSIPPI
BOARD OF WATER COMMISSIONERS
416 North State Street
Jackson, Mississippi 39201

WATER WELL DRILLERS LOG

July 14 1968 date well completed
Coble Water Supply firm name
Jackson county well located

LANDOWNER: R.T. Diamond description of formations encountered from to

Wade miss (mailing address) Clay 0 42
Sand 42 65

WELL LOCATION:
sec. 1 T 5 N R 6 E
9 1/2 miles North of M.P.
(distance) (direction) (nearest town)

WELL PURPOSE: home
(home, irrigation, municipal, industrial)

WELL COMPLETION DATA:

- (1) diameter (inches) 2"
- (2) total depth (feet) 65
- (3) static water level (feet) 36 ^{below} above top of ground.
- (4) casing gal. 60 (material) (depth)
- (size) if telescope see back.
- (5) screen 5 (length) 60 (depth to top)
- 2" Compugrip (size) (material)
- (6) pump (HP) (yield gpm)
- (type power)
- (7) electric log no (yes or no)

(organization running log)

(8) how well bottom plugged B.P. Valve


MAY 27 1968

MISS. BOARD OF WATER COMMISSIONERS

DRILLERS REMARKS: Pump installed by driller

If well telescopes please sketch and show depths.

GROUND LEVEL

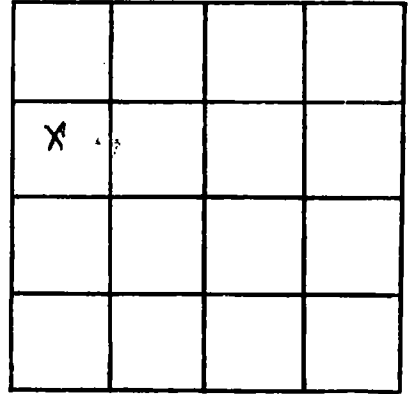

SECTION H

Please indicate well location X.

ADDITIONAL INFORMATION

If more than one screen, show locations of each on sketch.