

CODED

CODED

CODED

JACKSON
G 49
8-19-68

MISSISSIPPI  
 BOARD OF WATER COMMISSIONERS  
 416 North State Street  
 Jackson, Mississippi 39201

WATER WELL DRILLERS LOG

8-19 1968 Coast Water Well Serv. Jackson  
 date well completed firm name county well located

LANDOWNER: Lillian Faggard  
Wade, Miss  
 (mailing address)

description of formations encountered	from	to
<u>Red clay</u>	<u>0</u>	<u>14</u>
<u>med white sand</u>	<u>14</u>	<u>33</u>
<u>blue clay</u>	<u>33</u>	<u>63</u>
<u>med to coarse white sand</u>	<u>63</u>	<u>84</u>

WELL LOCATION:  
 sec 3 T S R 6  
S W  
1/2 miles W of Wade  
 (distance) (direction) (nearest town)

WELL PURPOSE: Home  
 (home, irrigation, municipal, industrial)

- WELL COMPLETION DATA:
- (1) diameter (inches) 2"
  - (2) total depth (feet) 84
  - (3) static water level (feet) 28 below above top of ground.
  - (4) casing galv. 79'  
 (material) (depth)  
2" if telescope see back.  
 (size)
  - (5) screen 5' 79'  
 (length) (depth to top)  
2" plastic  
 (size) (material)
  - (6) pump 1/2 8  
 (HP) (yield gpm)  
elec.  
 (type power)
  - (7) electric log NO  
 (yes or no)
  - (organization running log)
  - (8) how well bottom plugged Back  
work value

CODED


JAN 24 1969

MISS. BD. OF WATER COMM.

DRILLERS REMARKS:

If well telescopes please sketch and show depths.

GROUND LEVEL

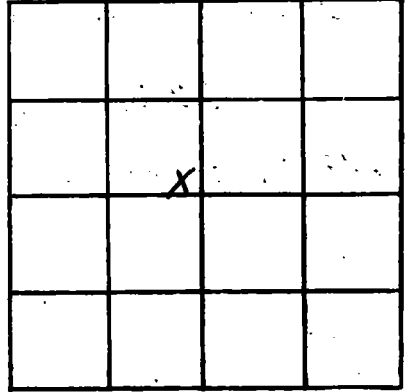

SECTION 02

Please indicate well location X.

ADDITIONAL INFORMATION

If more than one screen, show locations of each on sketch.