

Jackson
 G 50
 9-17-65

MISSISSIPPI
 BOARD OF WATER COMMISSIONERS
 416 North State Street
 Jackson, Mississippi 39201

CODED

WATER WELL DRILLERS LOG

Sept 17 1965 date well completed
 Cobble Water Supply firm name
 Jackson county well located

LANDOWNER: George
 Ireland
 Wade, Min
 (mailing address)


description of formations encountered	from	to
clay	0	22
sand	22	68

WELL LOCATION:
 sec. 23 T. 5 N R. 6 E
 15 miles North of ~~Miss Point~~
 (distance) (direction) (nearest town)

WELL PURPOSE: Drinking
 (home, irrigation, municipal, industrial)


- WELL COMPLETION DATA:
- (1) diameter (inches) 1 1/4
 - (2) total depth (feet) 68
 - (3) static water level (feet) 14 below above top of ground.
 - (4) casing Galv
 (material) (depth)
 (size) If telescope see back.
 - (5) screen 5' 63
 (length) (depth to top)
1 1/4 plastic
 (size) (material)
 - (6) pump _____
 (HP) (yield gpm)
 (type power)
 - (7) electric log no
 (yes or no)
 (organization running log)
 - (8) how well bottom plugged BP Valve

DRILLERS REMARKS: pump installed by owner

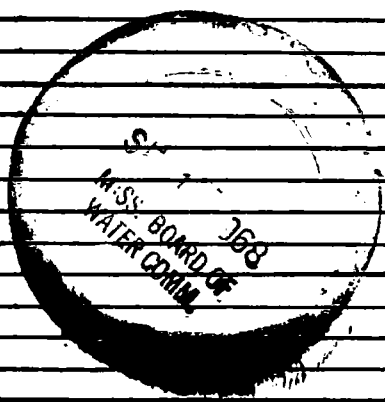

If well telescopes please
sketch and show depths.

GROUND LEVEL

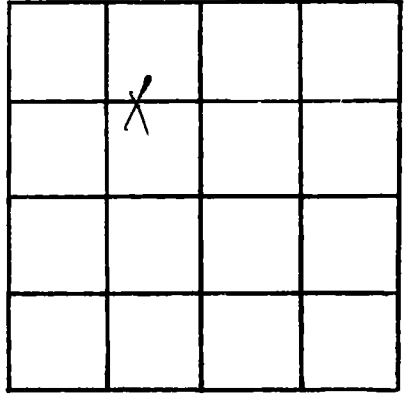

SECTION 23

Please indicate well location X.

ADDITIONAL INFORMATION

If more than one screen,
show locations of each on sketch.