

Jackson
 G51
 6-14-68

MISSISSIPPI
 BOARD OF WATER COMMISSIONERS
 416 North State Street
 Jackson, Mississippi 39201

CODED

WATER WELL DRILLERS LOG

6-14 1968 Coast Water Well Serv. Jackson
 date well completed firm name county well located

LANDOWNER: Guy Faggard

description of formations encountered	from	to
<u>Red Clay</u>	<u>0</u>	<u>14</u>
<u>Sand Fine-mud</u>	<u>14</u>	<u>32</u>
<u>Blue Clay</u>	<u>32</u>	<u>59</u>
<u>Sand med-Coarse</u>	<u>59</u>	<u>89</u>

P.O. Box 714

Osceola, Miss
 (mailing address)

WELL LOCATION:

sec. 3 T 5 N R. 6 E
 S W
1/2 miles W of Wade
 (distance) (direction) (nearest town)

WELL PURPOSE: Home
 (home, irrigation, municipal, industrial)

WELL COMPLETION DATA:

- (1) diameter (inches) 2"
- (2) total depth (feet) 89
- (3) static water level (feet) 24 below top of ground.
- (4) casing 2" galv., 84'
 (material) (depth)
2" if telescope see back.
 (size)
- (5) screen 5', 84'
 (length) (depth to top)
2", Stainless wrapped
 (size) (material)
- (6) pump 1/2, 8
 (HP) (yield gpm)
Elec.
 (type power)
- (7) electric log NO
 (yes or no)

CODED

(organization running log)

(8) how well bottom plugged Block
Wash Water


DEC 19 1968

MISS. BD. OF
 WATER COM.

DRILLERS REMARKS:

If well telescopes please sketch and show depths.

GROUND LEVEL

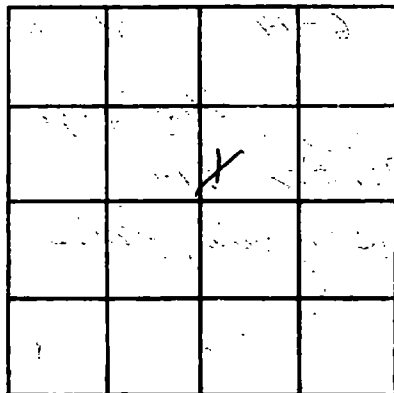

SECTION 3

Please indicate well location X.

ADDITIONAL INFORMATION

If more than one screen, show locations of each on sketch.