

Jackson.
 G 52
 1-66

MISSISSIPPI
 BOARD OF WATER COMMISSIONERS
 416 North State Street
 Jackson, Mississippi 39201

CODED

WATER WELL DRILLERS LOG

Jan 10 1966 date well completed
 North Water Supply Co. firm name
 county well located

LANDOWNER: Dolan
Smith
Wade
 (mailing address)

description of formations encountered	from	to
Clay	0	18
sand	18	94
Clay	484	491

WELL LOCATION:
 sec. 10 T. 5 N. R. 6 E.
2 miles S of Wade
 (distance) (direction) (nearest town)

WELL PURPOSE: Home
 (home, irrigation, municipal, industrial)

- WELL COMPLETION DATA:
- (1) diameter (inches) 2
 - (2) total depth (feet) 491
 - (3) static water level (feet) 2 ^{below} ~~above~~ top of ground.
 - (4) casing Galv. 486
 (material) (depth)
2x1 1/2 if telescope see back.
 (size)
 - (5) screen 5' 486
 (length) (depth to top)
1/4 Stamper Steel
 (size) (material)
 - (6) pump _____
 (HP) (yield gpm)
elec.
 (type power)
 - (7) electric log NO
 (yes or no)
 - (organization running log) _____
 - (8) how well bottom plugged B.P. Probe

CODED


MAR 10 1969

DRILLERS REMARKS: Pump installed by owner

MISS. BO. OF
 WATER COMMISSIONERS

If well telescopes please sketch and show depths.

GROUND LEVEL

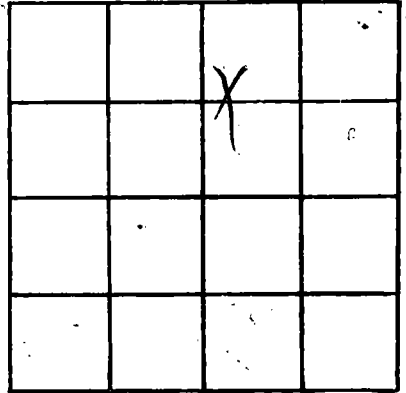

SECTION 10

Please indicate well location X.

ADDITIONAL INFORMATION

If more than one screen, show locations of each on sketch.