

Jackson  
G 53  
4-28-66

MISSISSIPPI CODED  
 BOARD OF WATER COMMISSIONERS  
 416 North State Street  
 Jackson, Mississippi 39201

WATER WELL DRILLERS LOG

April 28 1966 Colville Water Supply Jackson  
 date well completed firm name county well located

LANDOWNER: <u>Billy Wayne</u> <u>Sykes</u>	description of formations encountered	from	to
<u>Wade, Miss</u> (mailing address)			
	<u>clay</u>	<u>0</u>	<u>22</u>
	<u>Sand and gravel</u>	<u>22</u>	<u>86</u>
	<u>clay</u>	<u>86</u>	<u>242</u>
	<u>Sand</u>	<u>242</u>	<u>252</u>
	<u>clay</u>	<u>252</u>	<u>330</u>
	<u>Sand</u>	<u>330</u>	<u>353</u>

WELL LOCATION:  
 sec. 11 T. 5 N. R. 6 E.  
1 miles S of Wade  
 (distance) (direction) (nearest town)

WELL PURPOSE: home  
 (home, irrigation, municipal, industrial)

- WELL COMPLETION DATA:
- (1) diameter (inches) 2"
  - (2) total depth (feet) 353
  - (3) static water level (feet) 28" below above top of ground.
  - (4) casing Galv (material)          (depth)  
 (size) if telescope see back.
  - (5) screen 8' 345  
 (length) (depth to top)  
2" Copper gauze  
 (size) (material)
  - (6) pump          (HP)          (yield gpm)  
 (type power)
  - (7) electric log no  
 (yes or no)  
 (organization running log)
  - (8) how well bottom plugged B.P. Vally


DRILLERS REMARKS: pump not  
by owner

APR 21 1969

MISS. BD. OF  
 WATER COMM.

If well telescopes please sketch and show depths.

GROUND LEVEL

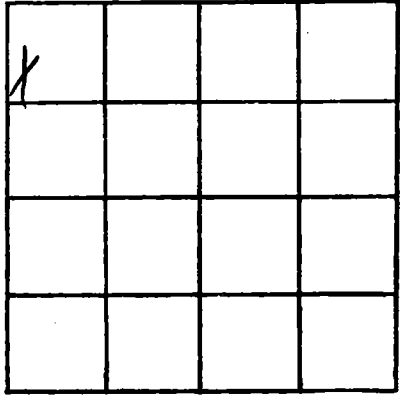

SECTION 11

Please indicate well location X:

ADDITIONAL INFORMATION

If more than one screen, show locations of each on sketch.