

Jackson  
 G55  
 11-21-66

MISSISSIPPI  
 BOARD OF WATER COMMISSIONERS  
 416 North State Street  
 Jackson, Mississippi 39201

CODED

WATER WELL DRILLERS LOG

Nov 21 1966 Mobile Water Supply Jackson  
 date well completed firm name county well located

LANDOWNER: B. Ernst  
Harvard  
Wade Miss  
 (mailing address)  
 WELL LOCATION:  
 sec. 11 T. 5 N. R. 6 E.  
2 miles S of Wade  
 (distance) (direction) (nearest town)

description of formations encountered	from	to
sand	0	80
clay	80	792
shaly sand & clay	792	814
sand	814	830

WELL PURPOSE: home  
 (home, irrigation, municipal, industrial)

WELL COMPLETION DATA:  
 (1) diameter (inches) 2"  
 (2) total depth (feet) 830  
 (3) static water level (feet) 21  below  above top of ground  
 (4) casing Galv  
 (material) (depth)  
 (size) If telescope see back.  
 (5) screen 10 820  
 (length) (depth to top)  
2" Stainless  
 (size) (material)  
 (6) pump \_\_\_\_\_  
 (HP) (yield gpm)  
 (type power)  
 (7) electric log no  
 (yes or no)  
 (organization running log)  
 (8) how well bottom plugged B.P. Valve


DRILLERS REMARKS:

APR 21 1969

MISS. BD. OF  
 WATER COMMISSIONERS

If well telescopes please sketch and show depths.

GROUND LEVEL

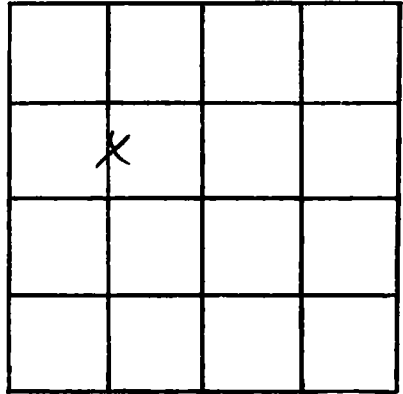

SECTION 11

Please indicate well location X.

ADDITIONAL INFORMATION

If more than one screen, show locations of each on sketch.