

Jackson  
 G57  
 3-7-67

MISSISSIPPI  
 BOARD OF WATER COMMISSIONERS  
 416 North State Street  
 Jackson, Mississippi 39201

WATER WELL DRILLERS LOG

March 7 1967 Colville Water Dept Jackson  
 date well completed firm name county well located


LANDOWNER: <u>CC. Webb</u>	description of formations encountered	from	to
<u>Cumbeet Bluff</u> (mailing address)	<u>full clay sand</u>	<u>6</u>	<u>12</u>
WELL LOCATION: sec. <u>21</u> T <u>5</u> N R <u>6</u> E <u>13</u> miles <u>North</u> of <u>M.P.</u> (distance) (direction) (nearest town)	<u>sand</u>	<u>20</u>	<u>30</u>
WELL PURPOSE: <u>camp</u> (home, irrigation, municipal, industrial)	<u>clay</u>	<u>30</u>	<u>50</u>
WELL COMPLETION DATA:  (1) diameter (inches) <u>2</u> (2) total depth (feet) <u>70</u> (3) static water level (feet) <u>10</u> <u>below</u> top of ground. (4) casing <u>galv</u> (material) (depth) _____ (size) If telescope see back. (5) screen <u>5</u> (length) <u>65</u> (depth to top) <u>2</u> (size) <u>stainless</u> (material) (6) pump _____ (HP) _____ (yield gpm) (type power) _____ (7) electric log <u>no</u> (yes or no) (organization running log) _____ (8) how well bottom plugged <u>B.P. Valve</u>	<u>50</u>	<u>70</u>	
DRILLERS REMARKS: <u>pump installed by owner</u>			

APR 21 1969

MISS. BD. OF  
 WATER COMMISSIONERS

If well telescopes please sketch and show depths.

GROUND LEVEL

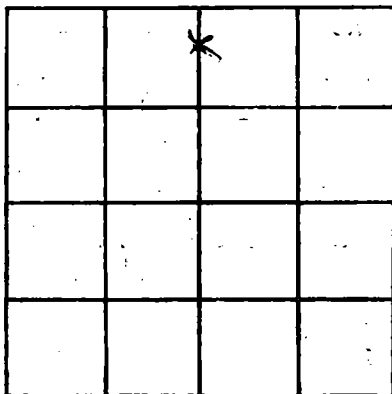

SECTION 27

Please indicate well location X.

ADDITIONAL INFORMATION

If more than one screen, show locations of each on sketch.