

Jackson
G58
3-11-67

CODED

MISSISSIPPI
 BOARD OF WATER COMMISSIONERS
 416 North State Street
 Jackson, Mississippi 39201

WATER WELL DRILLERS LOG

March 11 1967 Cabille Water Sup Jackson
 date well completed firm name county well located

| LANDOWNER: <u>Jack Wood</u> | description of formations encountered | from | to |
|--|---------------------------------------|------------|------------|
| <u>Wade Miss</u> (mailing address) | <u>Clay</u> | <u>0</u> | <u>10</u> |
| WELL LOCATION: sec. <u>14</u> T. <u>5</u> N. R. <u>6</u> E <u>4 1/2</u> miles <u>South</u> of <u>Wade</u> (distance) (direction) (nearest town) | <u>Sand</u> | <u>10</u> | <u>13</u> |
| WELL PURPOSE: <u>home</u> (home, Irrigation, municipal, industrial) | <u>Clay</u> | <u>13</u> | <u>44</u> |
| WELL COMPLETION DATA: (1) diameter (inches) <u>2</u> " | <u>sand</u> | <u>44</u> | <u>84</u> |
| (2) total depth (feet) <u>936</u> | <u>Clay</u> | <u>84</u> | <u>902</u> |
| (3) static water level (feet) <u>19</u> <u>below</u> <u>above</u> top of ground. | <u>sand</u> | <u>902</u> | <u>936</u> |
| (4) casing <u>galv</u> (material) (depth) (size) If telescope see back. | | | |
| (5) screen <u>10</u> <u>926</u> (length) (depth to top) | | | |
| <u>2 1/4</u> <u>stainless</u> (size) (material) | | | |
| (6) pump <u>no pump</u> (HP) (yield gpm) (type power) | | | |
| (7) electric log <u>no</u> (yes or no) | | | |
| (organization running log) | | | |
| (8) how well bottom plugged <u>BP</u> <u>valve</u> | | | |

CODED


APR 21 1969

MISS. BD. OF
 WATER COMM.

DRILLERS REMARKS:

If well telescopes please sketch and show depths.

GROUND LEVEL

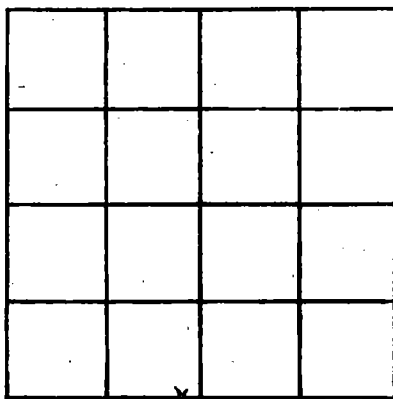

SECTION 14

Please indicate well location X.

ADDITIONAL INFORMATION

If more than one screen;
show locations of each on sketch.