

Jackson
 G59
 4-7-67

MISSISSIPPI
 BOARD OF WATER COMMISSIONERS CODED
 416 North State Street
 Jackson, Mississippi 39201

WATER WELL DRILLERS LOG

April 7 1967 Cabille Water Svc Jackson
 date well completed firm name county well located


LANDOWNER: <u>Julia Freeman</u>	description of formations encountered	from	to
<u>Wade</u> (mailing address)	<u>Clay</u> <u>Sand</u>	<u>0</u> <u>66</u>	<u>66</u> <u>79</u>
WELL LOCATION: sec. <u>26</u> T. <u>5</u> N. R. <u>6</u> E. <u>12</u> miles ^(S) <u>North</u> of ^(M) <u>MP</u> (distance) (direction) (nearest town)			
WELL PURPOSE: <u>home</u> (home, irrigation, municipal, industrial)			
WELL COMPLETION DATA: (1) diameter (inches) <u>2"</u> (2) total depth (feet) <u>79</u> (3) static water level (feet) <u>26</u> ^{below} above top of ground. (4) casing <u>galv</u> (material) (depth) _____ (size) If telescope see back. (5) screen <u>5'</u> (length) <u>74</u> (depth to top) (size) <u>2"</u> (material) <u>plastic</u> (6) pump <u>1/2</u> (HP) <u>5</u> (yield gpm) (type power) <u>elec</u> (7) electric log <u>no</u> (yes or no) (organization running log) _____ (8) how well bottom plugged <u>BP Water</u>			
DRILLERS REMARKS: _____			

APR 21 1969

MISS. BD. OF
 WATER COMM.

If well telescopes please sketch and show depths.

GROUND LEVEL

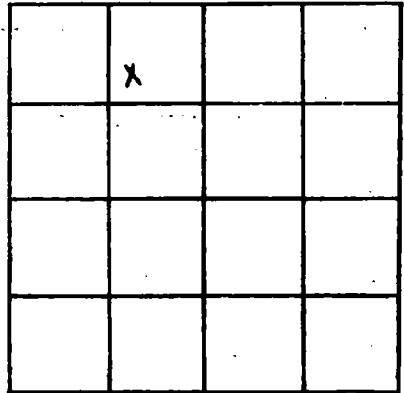

SECTION 26

Please indicate well location X.

ADDITIONAL INFORMATION

If more than one screen, show locations of each on sketch.