

Jackson  
 960  
 9-15-67

MISSISSIPPI  
 BOARD OF WATER COMMISSIONERS  
 416 North State Street  
 Jackson, Mississippi 39201

CODED

WATER WELL DRILLERS LOG

9/15 1967 well completed  
 Cahill Water Supply firm name  
 Jackson county well located


LANDOWNER: <u>Emmet Turner</u>	description of formations encountered	from	to
<u>Wade Miss</u> (mailing address)	<u>Clay</u>	<u>0</u>	<u>30</u>
WELL LOCATION:	<u>sand</u>	<u>30</u>	<u>88</u>
sec <u>10</u> T <u>5</u> N R <u>6</u> E <u>1 1/2</u> miles <u>South</u> of <u>Wade</u> (distance) (direction) (nearest town)	<u>Clay</u>	<u>88</u>	<u>351</u>
WELL PURPOSE: <u>Home</u> (home, irrigation, municipal, industrial)	<u>sand</u>	<u>351</u>	<u>393</u>
WELL COMPLETION DATA:			
(1) diameter (inches) <u>2</u>			
(2) total depth (feet) <u>393</u>			
(3) static water level (feet) <u>2</u> <u>below</u> <del>above</del> top of ground			
(4) casing <u>galv</u> (material) (depth)			
(size) If telescope see back.			
(5) screen <u>5</u> <u>388</u> (length) (depth to top)			
<u>2</u> <u>Stainless</u> (size) (material)			
(6) pump <u>1/2</u> <u>6</u> (HP) (yield gpm)			
<u>elec</u> (type power)			
(7) electric log <u>no</u> (yes or no)			
(organization running log)			
(8) how well bottom plugged <u>BPUabe</u>			
DRILLERS REMARKS:			

APR 21 1968

MISS. Bd. of  
 WATER COMM.

If well telescopes please sketch and show depths.

GROUND LEVEL

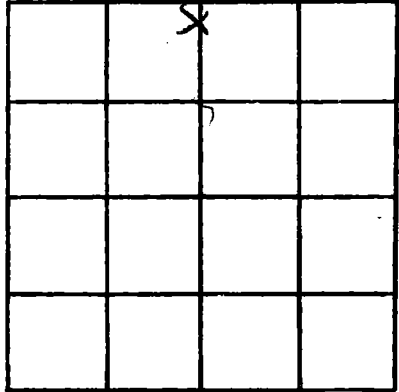

SECTION 10

Please indicate well location X.

ADDITIONAL INFORMATION

Form with multiple horizontal lines for writing additional information.

If more than one screen, show locations of each on sketch.