

CODED

MISSISSIPPI
BOARD OF WATER COMMISSIONERS
416 North State Street
Jackson, Mississippi 39201

WATER WELL DRILLERS LOG

Jackson
661
2-8-68

Feb 8 1968 Colville Water dug Jackson
date well completed firm name county well located

LANDOWNER: Gene Slavin

description of formations encountered

from

to

Wade Miss
(mailing address)

clay 0 10
sand 10 95
clay 95 238
sand 238 250

WELL LOCATION:

sec. 15 T. 5 N. R. 6 E.
1 1/2 miles south of Wade
(distance) (direction) (nearest town)

WELL PURPOSE: home
(home, irrigation, municipal, industrial)

WELL COMPLETION DATA:

- (1) diameter (inches) 2
(2) total depth (feet) 250
(3) static water level (feet) 19 below above top of ground.
(4) casing galv (material) (depth) (size) If telescope see back.
(5) screen 4 (length) 246 (depth to top) 2 (size) stainless (material)
(6) pump 1/2 (HP) 5 (yield gpm) elc (type power)
(7) electric log no (yes or no)

(organization running log)

(8) how well bottom plugged BP Valve


JAN - 8 1970

MRS. UD. OB
WATER COMM.

DRILLERS REMARKS:

If well telescopes please
sketch and show depths.

GROUND LEVEL

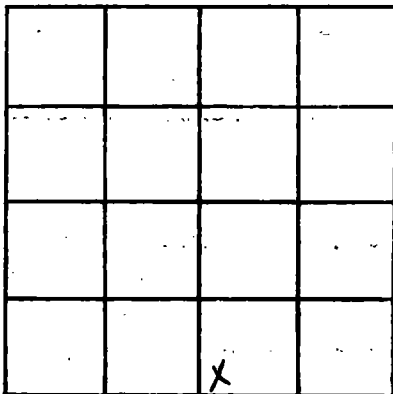

SECTION 15

Please indicate well location X.

ADDITIONAL INFORMATION

If more than one screen,
show locations of each on sketch.