

Jackson
G 63
2-6-70

MISSISSIPPI
BOARD OF WATER COMMISSIONERS
416 North State Street
Jackson, Mississippi 39201

CODED

WATER WELL DRILLERS LOG

2-6-70 date well completed Coast Water Well Service firm name Jackson county well located

LANDOWNER: <u>Jimmey Davis</u> <u>Star Route</u> <u>Lumbert, Miss.</u> (mailing address)	description of formations encountered	from	to
	<u>top soil + fine sand</u>	<u>0</u>	<u>30</u>
	<u>med. med. & coarse s.</u>	<u>30</u>	<u>70</u>
	<u>Blue clay + thin streaks sand</u>	<u>70</u>	<u>345</u>
	<u>sand fine to med.</u>	<u>345</u>	<u>377</u>
<p>WELL LOCATION:</p> <p>sec. <u>3</u> T-<u>5</u> R-<u>6</u> (distance) (direction) (nearest town)</p> <p><u>15</u> miles <u>N</u> of <u>Miss Point</u> (distance) (direction) (nearest town)</p> <p>WELL PURPOSE: <u>Home</u> (home, irrigation, municipal, industrial)</p> <p>WELL COMPLETION DATA:</p> <p>(1) diameter (inches) <u>2</u></p> <p>(2) total depth (feet) <u>377</u></p> <p>(3) static water level (feet) <u>6</u> below above top of ground.</p> <p>(4) casing <u>galv.</u> (material), <u>367'</u> (depth) <u>2"</u> (size) if telescope see back.</p> <p>(5) screen <u>10'</u> (length), <u>367'</u> (depth to top) <u>2"</u> (size), <u>Stainless Steel</u> (material)</p> <p>(6) pump <u>1</u> (HP), <u>10</u> (yield gpm) <u>Elec.</u> (type power)</p> <p>(7) electric log <u>N/O</u> (yes or no) (organization running log)</p> <p>(8) how well bottom plugged <u>Backfill</u> <u>Value</u></p>			
<p>DRILLERS REMARKS:</p>			


CODED

MAR 17 1970

MISS. DD. OF
WATER COMMISSIONERS

If well telescopes please sketch and show depths.

GROUND LEVEL

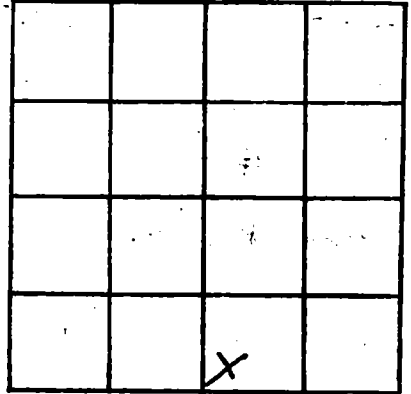

SECTION 3

Please indicate well location X.

ADDITIONAL INFORMATION

If more than one screen, show locations of each on sketch.