

JACKSON  
G-64  
7-22-70

MISSISSIPPI  
BOARD OF WATER COMMISSIONERS  
416 North State Street  
Jackson, Mississippi 39201

**CODED**

WATER WELL DRILLERS LOG

July 22 1970 Osborne Water Supply Jackson  
date/well completed firm name county well located

LANDOWNER: Walter Lee Waltherman Wade, Miss  
(mailing address)

description of formations encountered	from	to
<u>Clay</u>	<u>0</u>	<u>27</u>
<u>prob and sandy clay</u>	<u>27</u>	<u>106</u>
<u>Clay</u>	<u>106</u>	<u>232</u>
<u>sand</u>	<u>232</u>	<u>242</u>
<u>clay</u>	<u>242</u>	<u>325</u>
<u>sand</u>	<u>325</u>	<u>355</u>

WELL LOCATION:  
sec. 14 T. 5 N. R. 6 E.  
3 miles S of Wade  
(distance) (direction) (nearest town)

WELL PURPOSE: home  
(home, irrigation, municipal, industrial)

WELL COMPLETION DATA:

(1) diameter (inches) 2

(2) total depth (feet) 355

(3) static water level (feet) 3-5 <sup>below</sup> above top of ground.

(4) casing gal (material), 350 (depth)  
(size) if telescope see back.

(5) screen 5' (length), 350 (depth to top)  
2 (size), stainless (material)

(6) pump 0 (HP), (yield gpm)  
(type power)

(7) electric log no (yes or no)  
(organization running log)

(8) how well bottom plugged BP valve

**CODED**


DRILLERS REMARKS: \_\_\_\_\_

MISS. BD. OF WATER COMM.

5 0 11 1970

If well telescopes please sketch and show depths.

GROUND LEVEL

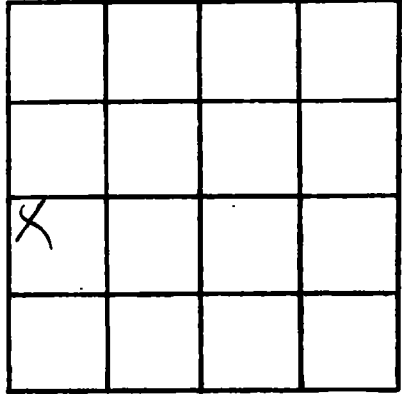

SECTION 14

Please indicate well location X.

ADDITIONAL INFORMATION

If more than one screen, show locations of each on sketch.