

Jackson  
G 65  
12-10-68

MISSISSIPPI  
BOARD OF WATER COMMISSIONERS  
416 North State Street  
Jackson, Mississippi 39201

**CODED**

**WATER WELL DRILLERS LOG**

Dec 10 1968 Cobille Water Supply Jackson  
date well completed firm name county well located


LANDOWNER: <u>Wayne Powell</u>	description of formations encountered	from	to
<u>Wade Min.</u> (mailing address)	<u>clay</u>	<u>5</u>	<u>44</u>
WELL LOCATION: sec. <u>26</u> T. <u>5</u> N. R. <u>6</u> E. <u>11</u> miles <u>N</u> of <u>Miss Forest</u> (distance) (direction) (nearest town)		<u>44</u>	<u>56</u>
WELL PURPOSE: <u>home</u> (home, irrigation, municipal, industrial)			
WELL COMPLETION DATA: (1) diameter (inches) <u>2</u> (2) total depth (feet) <u>56</u> (3) static water level (feet) <u>33</u> <u>below</u> above top of ground. (4) casing <u>galv.</u> (material), (depth) (size) if telescope see back. (5) screen <u>4</u> (length), <u>53</u> (depth to top) <u>2</u> (size), <u>plastic</u> (material) (6) pump (HP) (yield gpm) (type power) (7) electric log <u>no</u> (yes or no) (organization running log) (8) how well bottom plugged <u>BP Water</u>	<b>CODED</b>		
DRILLERS REMARKS: <u>pump installed by owner</u>			

JUN 19 1970

MISS. BD. OF  
WATER COMMISSIONERS

If well telescopes please sketch and show depths.

GROUND LEVEL

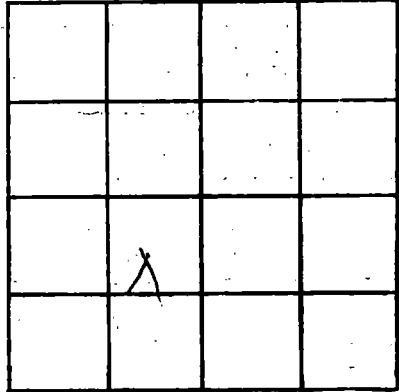

SECTION 26

Please indicate well location X.

ADDITIONAL INFORMATION

If more than one screen, show locations of each on sketch.