

Jackson
G 66
5-28-70

MISSISSIPPI
BOARD OF WATER COMMISSIONERS
416 North State Street
Jackson, Mississippi 39201

CODED

WATER WELL DRILLERS LOG

5/29/70 date well completed
1970 M. H. Well Co firm name
Jackson county well located

LANDOWNER: Watson
Pascagoula Miss
(mailing address)

WELL LOCATION:
sec. 2 T. 6 N. R. 6 E.
4 miles S of Three Rivers
(distance) (direction) (nearest town)

WELL PURPOSE: Home
(home, irrigation, municipal, industrial)

WELL COMPLETION DATA:

- (1) diameter (inches) 2"
- (2) total depth (feet) 291
- (3) static water level (feet) 0 below top of ground.
- (4) casing Plastic, 281
(material) (depth)
(size) if telescope see back.
- (5) screen 10ft, 281
(length) (depth to top)
2" Plastic
(size) (material)
- (6) pump flowed 2 1/2
(HP) (yield gpm)
(type power)
- (7) electric log No
(yes or no)
(organization running log)
- (8) how well bottom plugged Back
wash Valve

description of formations encountered	from	to
Dirt	0	2
yellow clay	2	15
Sand	15	105
Blue clay	105	238
Sand	238	242
Blue clay	240	251
Silt Sand	251	271
Course Sand	271	291


CODED

JUN 15 1970

DRILLERS REMARKS:

If well telescopes please sketch and show depths.

GROUND LEVEL

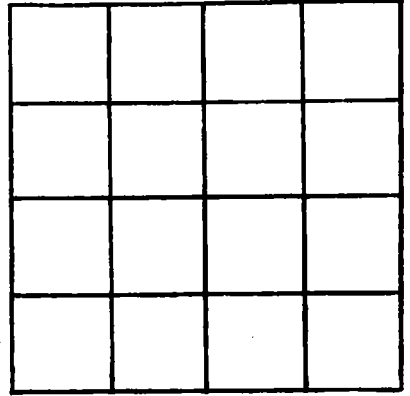

SECTION _____

Please indicate well location X.

ADDITIONAL INFORMATION

If more than one screen, show locations of each on sketch.