




If well telescopes please sketch and show depths.

**GROUND LEVEL**

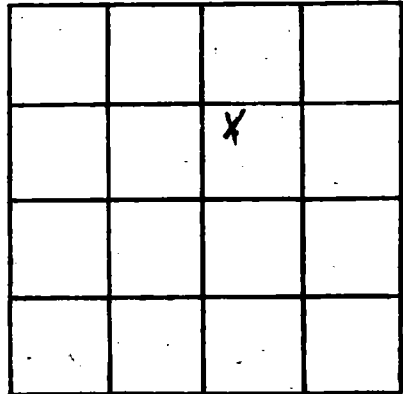

**SECTION 22**

**Please indicate well location X.**

**ADDITIONAL INFORMATION**

If more than one screen,  
show locations of each on sketch.