

Jackson
G 69

MISSISSIPPI
BOARD OF WATER COMMISSIONERS
416 North State Street
Jackson, Mississippi 39201

CODED

WATER WELL DRILLERS LOG

19 Colville Water Supply firm name Jackson county well located

LANDOWNER: Ellis Holland

description of formations encountered	from	to
deepening hole from 128'		
sand	128	132
clay	132	205
gravel	205	211
clay	211	264
sand	264	292

Wade Miss
(mailing address)

WELL LOCATION:
sec. 23 T. 5 N. R. 6 E.
12 miles North of Marion
(distance) (direction) (nearest town)

WELL PURPOSE: home
(home, irrigation, municipal, industrial)

- WELL COMPLETION DATA:
- (1) diameter (inches) 2
 - (2) total depth (feet) 278
 - (3) static water level (feet) 15-4 "below top of ground. above"
 - (4) casing galv (material) (depth) _____
(size) If telescope see back.
 - (5) screen 5' (length) 273 (depth to top)
2 (size) stainless (material)
 - (6) pump 3/4 (HP) 6 (yield gpm)
elec (type power)
 - (7) electric log no (yes or no)
(organization running log) _____
 - (8) how well bottom plugged B.P. Value

CODED


JUL 27 1970

DRILLERS REMARKS:

MISS. REG. OF
WATER COMM.

If well telescopes please sketch and show depths.

GROUND LEVEL

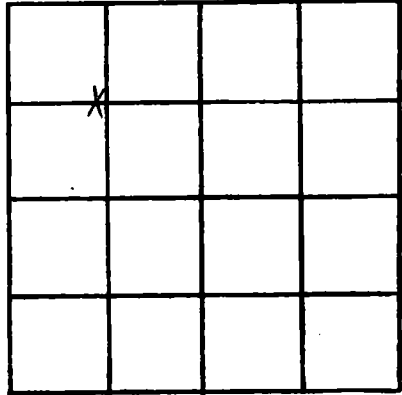

SECTION 23

Please indicate well location X.

ADDITIONAL INFORMATION

If more than one screen, show locations of each on sketch.