

JACKSON
G 70
7-18-70

MISSISSIPPI
BOARD OF WATER COMMISSIONERS
416 North State Street
Jackson, Mississippi 39201

CODED

WATER WELL DRILLERS LOG

July 18 1970 Colville Water Supply Jackson
date well completed firm name county well located

LANDOWNER: Robert
V. Davis
Wade
(mailing address)

description of formations encountered	from	to
sandy clay	0	27
sand	27	53
wood and sand	53	63
sand clay	63	75
clay	75	221
sand fine	221	237
Clay	237	337
sand	337	384

WELL LOCATION:
sec. 4 T 5 N R 6 E
1 1/2 miles South of Wade
(distance) (direction) (nearest town)

WELL PURPOSE: Home
(home, irrigation, municipal, industrial)

WELL COMPLETION DATA:

(1) diameter (inches) 2

(2) total depth (feet) 384

(3) static water level (feet) 5 1/2 below top of ground

(4) casing galv, 379
(material) (depth)

(size) If telescope see back.

(5) screen 5', 379
(length) (depth to top)

2, stainless
(size) (material)

(6) pump 1/2, 6
(HP) (yield gpm)

elec
(type power)

(7) electric log no
(yes or no)

(organization running log)

(8) how well bottom plugged BP Valve


CODED

AUG 17 1970

DRILLERS REMARKS:

If well telescopes please sketch and show depths.

GROUND LEVEL

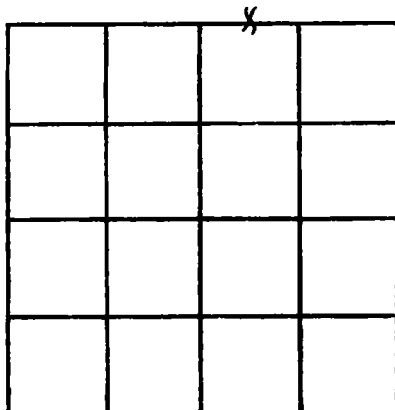

SECTION 11

Please indicate well location X.

ADDITIONAL INFORMATION

If more than one screen, show locations of each on sketch.