

JACKSON  
 G 71  
 7-22-70

MISSISSIPPI  
 BOARD OF WATER COMMISSIONERS  
 416 North State Street  
 Jackson, Mississippi 39201

**CODED**

WATER WELL DRILLERS LOG

July 22 1970 Cobble Water Supply Jackson  
 date well completed firm name county well located

LANDOWNER: Andrew Cobble  
 and Mr. Raso  
 Columbus Bluff  
 (mailing address)

description of formations encountered	from	to
fine clay	2	10
sand and gravel	10	69
clay	69	111
sand	111	160
clay?		
set at 132 Cut to 384 dry		

WELL LOCATION:  
 sec 27 T-5 N R-6 E  
 12 miles North of M.P.  
 (distance) (direction) (nearest town)

WELL PURPOSE: Camp  
 (home, irrigation, municipal, industrial)

- WELL COMPLETION DATA:
- (1) diameter (inches) 2
  - (2) total depth (feet) 132
  - (3) static water level (feet) 22 <sup>below</sup> <sub>above</sub> top of ground.
  - (4) casing galv. 127  
 (material) (depth)
  - (size) If telescope see back.
  - (5) screen 5' 127  
 (length) (depth to top)
  - 2 3' inchless  
 (size) (material)
  - (6) pump 3/4 9  
 (HP) (yield gpm)
  - elec  
 (type power)
  - (7) electric log no  
 (yes or no)
  - (organization running log)
  - (8) how well bottom plugged BP Value

**CODED**


AUG 17 1970

MISS. BD. OF  
 WATER COMM.

DRILLERS REMARKS:

If well telescopes please sketch and show depths.

GROUND LEVEL

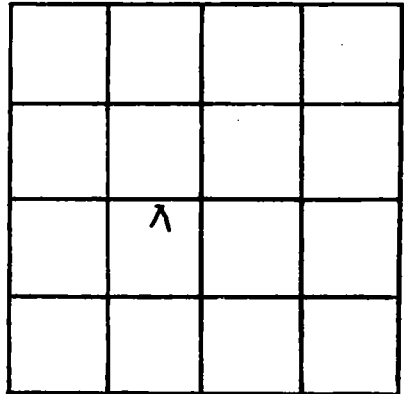

SECTION 27

Please indicate well location X.

ADDITIONAL INFORMATION

If more than one screen, show locations of each on sketch.