

JACKSON
 G 72
 8-5-70

MISSISSIPPI
 BOARD OF WATER COMMISSIONERS
 416 North State Street
 Jackson, Mississippi 39201

CODED

WATER WELL DRILLERS LOG

Aug 5 1970 Colville Water Supply firm name Jackson county well located
 date well completed

LANDOWNER: Cl. F. Scarborough
Wade, Miss
 (mailing address)

description of formations encountered	from	to
pipe clay	0	26
sand	26	65
clay	65	131
fine sand	131	141
mud	141	152

WELL LOCATION:
 sec. 27 T 5 N R 6 E
12 miles North of MP
 (distance) (direction) (nearest town)

WELL PURPOSE: Camp
 (home, irrigation, municipal, industrial)

WELL COMPLETION DATA:

(1) diameter (inches) 2

(2) total depth (feet) 152

(3) static water level (feet) 5 ^(below) _(above) top of ground.

(4) casing galv. 147
 (material) (depth)
 (size) if telescope see back.

(5) screen 5 147
 (length) (depth to top)
2 stainless
 (size) (material)

(6) pump 1/2 7
 (HP) (yield gpm)
elec
 (type power)

(7) electric log no
 (yes or no)

(organization running log)

(8) how well bottom plugged BP Valve

CODED


AUG 17 1970

DRILLERS REMARKS:

MISS. BD. OF
 WATER COMM.

If well telescopes please sketch and show depths.

GROUND LEVEL

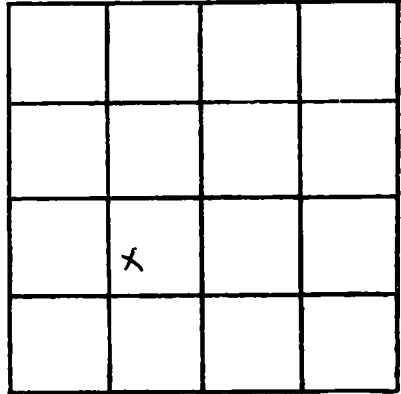

SECTION 27

Please indicate well location X.

ADDITIONAL INFORMATION

If more than one screen, show locations of each on sketch.