

JACKSON
G73
1-5-71

MISSISSIPPI
BOARD OF WATER COMMISSIONERS
416 North State Street
Jackson, Mississippi 39201

CODED

WATER WELL DRILLERS LOG

Jan 5 1971 Colville Water Supply Jackson
date well completed firm name county well located

| LANDOWNER: <u>Clarence Foster</u> | description of formations encountered | from | to |
|---|---------------------------------------|------------|------------|
| <u>Wade Miss</u> (mailing address) | | | |
| WELL LOCATION: sec. <u>15</u> T <u>5</u> N R <u>6</u> E <u>14</u> miles <u>North</u> of <u>M.P.</u> (distance) (direction) (nearest town) | <u>Clay</u> | <u>0</u> | <u>30</u> |
| | <u>sand and gravel</u> | <u>30</u> | <u>110</u> |
| WELL PURPOSE: <u>home</u> (home, irrigation, municipal, industrial) | <u>clay</u> | <u>110</u> | <u>176</u> |
| | <u>sand</u> | <u>176</u> | <u>186</u> |
| WELL COMPLETION DATA: (1) diameter (inches) <u>2</u> (2) total depth (feet) <u>802</u> (3) static water level (feet) <u>18</u> <u>below</u> top of ground. <u>above</u> (4) casing <u>galv</u> <u>787</u> (material) (depth) <u>2</u> if telescope see back. (size) (5) screen <u>15'</u> <u>787</u> (length) (depth to top) <u>2</u> <u>stainless</u> (size) (material) (6) pump _____ (HP) _____ (yield gpm) _____ (type power) (7) electric log <u>no</u> (yes or no) _____ (organization running log) (8) how well bottom plugged <u>BP Valve</u> | <u>fract of sand and gravel</u> | <u>186</u> | <u>236</u> |
| | <u>sand</u> | <u>236</u> | <u>270</u> |
| | <u>Clay</u> | <u>270</u> | <u>550</u> |
| | <u>sand</u> | <u>550</u> | <u>572</u> |
| | <u>clay</u> | <u>572</u> | <u>709</u> |
| | <u>sand</u> | <u>709</u> | <u>718</u> |
| | <u>clay</u> | <u>718</u> | <u>785</u> |
| | <u>sand</u> | <u>785</u> | <u>862</u> |

CODED


JAN 25 1971

MISS. BD. OF
WATER COM.

DRILLERS REMARKS: Pump installed by owner - flow rate in atmosphere 30 G.P.M.

If well telescopes please sketch and show depths.

GROUND LEVEL

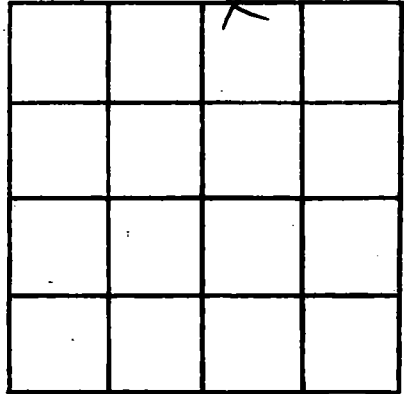

SECTION 15

Please indicate well location X.

ADDITIONAL INFORMATION

If more than one screen,
show locations of each on sketch.