

JACKSON  
G 74  
2-22-71

MISSISSIPPI  
BOARD OF WATER COMMISSIONERS  
416 North State Street  
Jackson, Mississippi 39201

**CODED**

WATER WELL DRILLERS LOG

Feb 22 1971 data well completed  
Colville Water Sys firm name  
Jackson county well located

| LANDOWNER:                         | description of formations encountered | from | to  |
|------------------------------------|---------------------------------------|------|-----|
| John Pope                          |                                       |      |     |
| Cumbeet Bluff<br>(mailing/address) | sand                                  | 0    | 69  |
|                                    | clay                                  | 69   | 140 |
|                                    | sand                                  | 140  | 155 |

WELL LOCATION:  
sec. 2 T 5 N R 6 E  
12 miles (distance) N of MP (direction) (nearest town)

WELL PURPOSE: drinking  
(home, irrigation, municipal, industrial)

- WELL COMPLETION DATA:
- (1) diameter (inches) 2
  - (2) total depth (feet) 155
  - (3) static water level (feet) 2 <sup>below</sup>/<sub>above</sub> top of ground.
  - (4) casing galv 150  
(material) (depth)
  - if telescope see back.  
(size)
  - (5) screen 5' 150  
(length) (depth to top)
  - 2 stainless  
(size) (material)
  - (6) pump 1/2 8  
(HP) (yield gpm)
  - elec  
(type power)
  - (7) electric log no  
(yes or no)
  - (organization running log)
  - (8) how well bottom plugged BP Johnson

**CODED**


MAR 25 1971

MISS. BD. OF  
WATER COMM.

DRILLERS REMARKS:

If well telescopes please sketch and show depths.

GROUND LEVEL

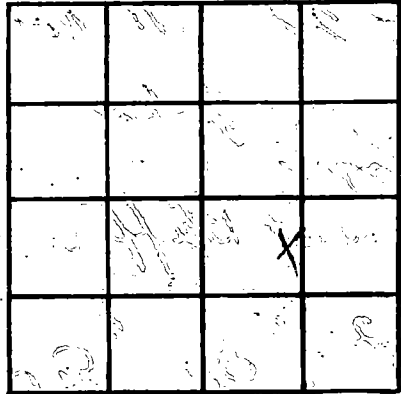

SECTION 28

Please indicate well location X.

ADDITIONAL INFORMATION

If more than one screen, show locations of each on sketch.