

JACKSON
G 76
5-21-71

MISSISSIPPI
BOARD OF WATER COMMISSIONERS
416 North State Street
Jackson, Mississippi 39201

CODED

WATER WELL DRILLERS LOG

May 21 1971 Colville Water Supply Jackson
date well completed firm name county well located

LANDOWNER: <u>Donald McPherson</u> <u>Cumbeet Bluff Miss.</u> (mailing address)	description of formations encountered	from	to
	Chy	9	16
	Sand	16	50
	Clay	50	132
	Clay	9	132
	<u>sand</u>	132	158
WELL LOCATION:			
sec. <u>27</u> T <u>5</u> N R. <u>6</u> E			
<u>12</u> miles <u>North</u> of <u>M.P.</u>			
(distance) (direction) (nearest town)			
WELL PURPOSE: <u>Camp</u>			
(home, irrigation, municipal, industrial)			
WELL COMPLETION DATA:			
(1) diameter (inches) <u>2</u>			
(2) total depth (feet) <u>158</u>			
(3) static water level (feet) <u>5'</u> <u>below</u> <u>above</u> top of ground.			
(4) casing <u>gravel</u> <u>153</u>			
(material) (depth)			
(size) If telescope see back.			
(5) screen <u>5'</u> <u>153</u>			
(length) (depth to top)			
<u>2"</u> <u>Stainl.</u>			
(size) (material)			
(6) pump <u>1/2</u> <u>6</u>			
(HP) (yield gpm)			
<u>elec.</u>			
(type power)			
(7) electric log <u>No</u>			
(yes or no)			
(organization running log)			
(8) how well bottom plugged <u>B.P.</u>			
<u>Valve</u>			

CODED


JUL 19 1971

MISS. BD. OF
WATER COMM.

DRILLERS REMARKS:

If well telescopes please sketch and show depths.

GROUND LEVEL

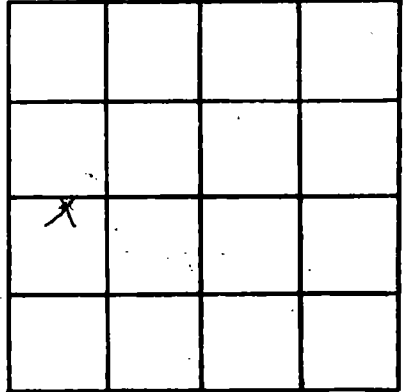

SECTION 27

Please indicate well location X.

ADDITIONAL INFORMATION

If more than one screen, show locations of each on sketch.