

Jackson
G-79
8-4-71

MISSISSIPPI
BOARD OF WATER COMMISSIONERS
416 North State Street
Jackson, Mississippi 39201

WATER WELL DRILLERS LOG

CODED

Aug 4 1971 data/well completed
21 Colville Water Supply firm name
Jackson county well located

LANDOWNER:	description of formations encountered	from	to
Martin Mills	Clay	0	30
Wade Miss. (mailing address)	Sand	30	90
	Clay	90	360
	Sand	360	405
	Clay	405	726
	Sand	714	726

WELL LOCATION:
sec. 24 T 8 N R 2 E
12 miles North of MP
(distance) (direction) (nearest town)

WELL PURPOSE: Home
(home, irrigation, municipal, industrial)

WELL COMPLETION DATA:

(1) diameter (inches) 2

(2) total depth (feet) 726

(3) static water level (feet) 2 ^{below} above top of ground.

(4) casing galv (material), 716 (depth)

 If telescope see back.
(size)

(5) screen 10 (length), 716 (depth to top)

2 (size), Stainless (material)

(6) pump (HP), (yield gpm)

 (type power)

(7) electric log No (yes or no)

 (organization running log)

(8) how well bottom plugged BP Valve


SEP 2 1971

MISS. BD. OF
WATER COMM.

DRILLERS REMARKS: Pump installed by owner

If well telescopes please sketch and show depths.

GROUND LEVEL

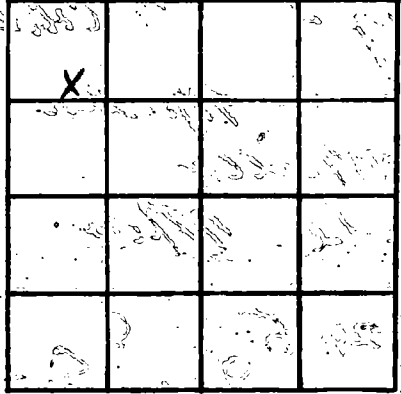

SECTION 24

Please indicate well location X.

ADDITIONAL INFORMATION

If more than one screen, show locations of each on sketch.