

JACKSON
G 82
9-1-71

MISSISSIPPI
BOARD OF WATER COMMISSIONERS
416 North State Street
Jackson, Mississippi 39201

CODED

WATER WELL DRILLERS LOG

Sept 1 1971 date well completed
Colville Water Supply firm name
Jackson county well located

LANDOWNER: B. H. Gibson
Wade Miss (mailing address)

WELL LOCATION:
sec. 26 T. 5 N R. 6 E
12 miles North of M.P.
(distance) (direction) (nearest town)

WELL PURPOSE: Home
(home, irrigation, municipal, industrial)

- WELL COMPLETION DATA:
- (1) diameter (inches) 2
 - (2) total depth (feet) 376
 - (3) static water level (feet) 5 below top of ground ~~above~~
 - (4) casing galv (material), 366 (depth)
 - (size) if telescope see back.
 - (5) screen 10 (length), 366 (depth to top)
 - 2 (size), Stamlers (material)
 - (6) pump (HP), (yield gpm)
 - (type power)
 - (7) electric log no (yes or no)
 - (organization running log)
 - (8) how well bottom plugged BP valve


description of formations encountered	from	to
Sandy Clay	0	44
Shale	44	80
Clay	80	358
sand	358	376

CODED

DRILLERS REMARKS: pump installed by owner

If well telescopes please sketch and show depths.

GROUND LEVEL

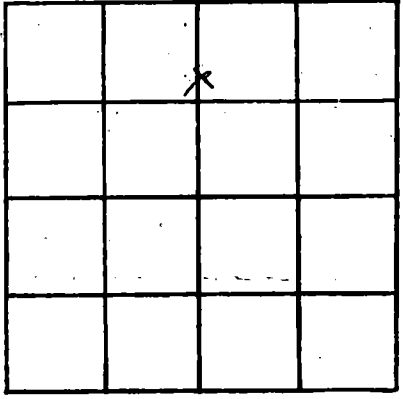

SECTION 26

Please indicate well location X.

ADDITIONAL INFORMATION

Lined area for additional information.

If more than one screen, show locations of each on sketch.