

JACKSON  
G 85  
5-15-72

MISSISSIPPI  
BOARD OF WATER COMMISSIONERS  
416 North State Street  
Jackson, Mississippi 39201

**CODED**

WATER WELL DRILLERS LOG

MAY 15 1972 Colville Water Sup. Jackson  
date well completed firm name county well located

LANDOWNER: Claude Nolf Wade Ms  
(mailing address)

description of formations encountered	from	to
Clay	0	27
Sand	27	100
Clay	100	125
Sand	125	174

WELL LOCATION:  
sec. 27 T. 5 N. R. 6 E.  
12 miles North of MP  
(distance) (direction) (nearest town)

WELL PURPOSE: home  
(home, irrigation, municipal, industrial)

WELL COMPLETION DATA:

(1) diameter (inches) 2

(2) total depth (feet) 174

(3) static water level (feet) 30 below above top of ground.

(4) casing galv., 169  
(material) (depth)

(size) If telescope see back.

(5) screen 5', 169  
(length) (depth to top)

2", STAINLESS  
(size) (material)

(6) pump \_\_\_\_\_ (HP) \_\_\_\_\_ (yield gpm)

(type power)

(7) electric log NO  
(yes or no)

(organization running log)

(8) how well bottom plugged BP Kellog

**CODED**


MAY 24 1972

MISS. BD. OF  
WATER COMM.

DRILLERS REMARKS: pump installed by owner

If well telescopes please sketch and show depths.

GROUND LEVEL

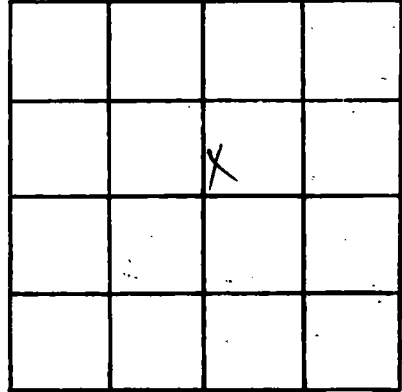

SECTION 27

Please indicate well location X.

ADDITIONAL INFORMATION

If more than one screen, show locations of each on sketch.