

JACKSON
G86
5-15-72

MISSISSIPPI
BOARD OF WATER COMMISSIONERS
416 North State Street
Jackson, Mississippi 39201

CODED

WATER WELL DRILLERS LOG

May 15 1972 Cahilla, W.S. Jackson
 (date well completed) (firm name) (county well located)

LANDOWNER: Claude Nolf
 Wade, M.S.
 (mailing address)

description of formations encountered	from	to
clay	0	27
sand	27	100
clay	100	125
sand	125	174

WELL LOCATION:
 sec. 27 T. 5 N R. 6 E
 (S) (W)
 15 miles N of Mountaintop
 (distance) (direction) (nearest town)

WELL PURPOSE: home
 (home, irrigation, municipal, industrial)

- WELL COMPLETION DATA:
- diameter (inches) 2
 - total depth (feet) 174
 - static water level (feet) 12 ^{below}/_{above} top of ground.
 - casing galv. 169
 (material) (depth)
 (size) if telescope see back.
 - screen 5' 169
 (length) (depth to top)
 2" stainless
 (size) (material)
 - pump (HP) (yield gpm)
 (type power)
 - electric log no
 (yes or no)
 (organization running log)
 - how well bottom plugged BP Valve

CODED


SEP 28 1972

MISS. BL
 WATER 1971

DRILLERS REMARKS: pump installed by owner

If well telescopes please sketch and show depths.

GROUND LEVEL

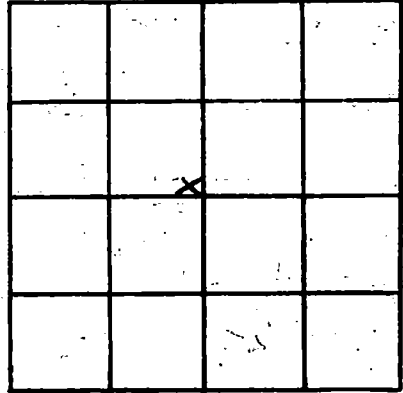

SECTION 27

Please indicate well location X.

ADDITIONAL INFORMATION

COPIED

If more than one screen, show locations of each on sketch.