

JACKSON

G 91

10-27-72

MISSISSIPPI
 BOARD OF WATER COMMISSIONERS
 416 North State Street
 Jackson, Mississippi 39201

WATER WELL DRILLERS LOG

10-27-72
date well completed

Griffin Well Co
firm name

Jackson
county well located

LANDOWNER: Edward

description of formations encountered

from to

Singerton, 1704 College
St. Moss Point Miss
(mailing address)

Red clay	0	3
White clay	3	20
Yellow sand	20	25
Coarse white sand	25	50
grey marine clay	50	62
sand & clay streaks	62	78
Blue clay	78	142
med. white sand	142	160

WELL LOCATION:

sec 27 T 5 N R 6 E
S W
1/2 miles S of WADE
(distance) (direction) (nearest town)

WELL PURPOSE: Home
(home, irrigation, municipal, industrial)

WELL COMPLETION DATA:

- (1) diameter (inches) 2
- (2) total depth (feet) 160
- (3) static water level (feet) 20 below top of ground.
- (4) casing STEEL 151 (material) (depth)
- (5) screen 4' 151 (length) (depth to top)
- 2" STAINLESS (size) (material)
- (6) pump 1 40 (HP) (yield gpm)
- FLC (type power)
- (7) electric log NO (yes or no)

CODED

(organization running log)


(8) how well bottom plugged
ROCK WASH VALUE

DRILLERS REMARKS:

10-30-72

If well telescopes please sketch and show depths.

GROUND LEVEL

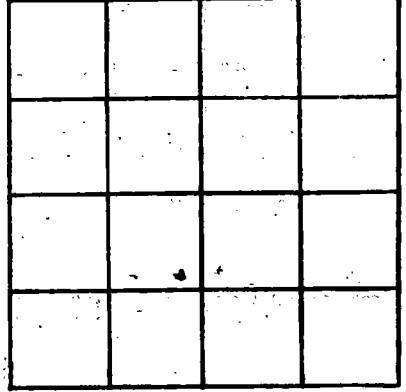

SECTION 27

Please indicate well location X.

ADDITIONAL INFORMATION

If more than one screen, show locations of each on sketch.