

JACKSON
G 92
10-19-72

MISSISSIPPI
BOARD OF WATER COMMISSIONERS
416 North State Street
Jackson, Mississippi 39201


WATER WELL DRILLERS LOG

Oct 19 1972 Colville Water Supply Jackson
date well completed firm name county well located

LANDOWNER: <u>Richard Goff Wade Ms</u> (mailing address)	description of formations encountered	from	to
WELL LOCATION: sec. <u>3</u> T <u>5</u> N R <u>6</u> E <u>16</u> miles <u>N</u> of <u>MP</u> (distance) (direction) (nearest town)	<u>pipe clay</u> <u>sand</u> <u>clay</u> <u>sand</u>	<u>0</u> <u>21</u> <u>115</u> <u>259</u>	<u>21</u> <u>115</u> <u>259</u> <u>270</u>
WELL PURPOSE: <u>Home</u> (home, irrigation, municipal, industrial)			
WELL COMPLETION DATA: (1) diameter (inches) <u>2"</u> (2) total depth (feet) <u>270</u> (3) static water level (feet) <u>1</u> <u>below</u> above top of ground (4) casing <u>galv</u> , <u>260</u> , (material) (depth) <u>2</u> if telescope see back. (size) (5) screen <u>10'</u> , <u>260</u> (length) (depth to top) <u>2</u> , <u>stainless</u> (size) (material) (6) pump <u>A</u> (HP) (yield gpm) <u>NO</u> (type power) (7) electric log <u>NO</u> (yes or no) <u>BP Valve</u> (organization running log) (8) how well bottom plugged			
DRILLERS REMARKS: <u>pump installed by owner</u>			

If well telescopes please sketch and show depths.

GROUND LEVEL

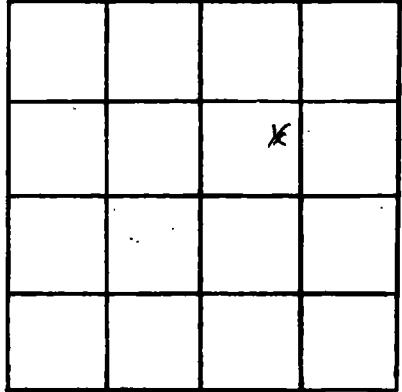

SECTION _____

Please indicate well location X.

ADDITIONAL INFORMATION

Lined area for additional information.

If more than one screen, show locations of each on sketch.