

JACKSON
G93
10-19-72

MISSISSIPPI
BOARD OF WATER COMMISSIONERS
416 North State Street
Jackson, Mississippi 39201

CODED

WATER WELL DRILLERS LOG


Oct 19 1972 data well completed
Colville Water Supply firm name
Jackson county well located

LANDOWNER: <u>Richard Goff</u>	description of formations encountered	from	to
<u>Wade Ms</u> (mailing address)	<u>pipe clay</u>	0	21
	<u>sand</u>	21	94
	<u>clay</u>	94	241
	<u>sand</u>	241	256
WELL LOCATION: sec <u>3</u> T <u>5</u> N R <u>6</u> E <u>16</u> miles <u>North</u> of <u>M.P.</u> (distance) (direction) (nearest town)			
WELL PURPOSE: <u>home</u> (home, irrigation, municipal, industrial)			
WELL COMPLETION DATA: (1) diameter (inches) <u>2</u> (2) total depth (feet) <u>256</u> (3) static water level (feet) <u>6"</u> ^{below} above top of ground. (4) casing <u>galv</u> , <u>25'</u> , (material) (depth) (size) if telescope see back. (5) screen <u>5'</u> , <u>256</u> (length) (depth to top) <u>2"</u> , <u>stain</u> (size) (material) (6) pump _____ (HP) _____ (yield gpm) (type power) (7) electric log <u>no</u> (yes or no) (organization running log) (8) how well bottom plugged <u>BPI w/ bot</u>			
DRILLERS REMARKS: <u>pump installed by owner</u>			

CODED

If well telescopes please sketch and show depths.

GROUND LEVEL

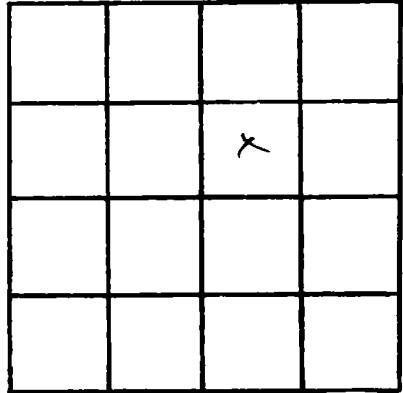

SECTION 3

Please indicate well location X.

ADDITIONAL INFORMATION

If more than one screen, show locations of each on sketch.