

JACKSON
G 94
4-6-73

MISSISSIPPI
 BOARD OF WATER COMMISSIONERS
 416 North State Street
 Jackson, Mississippi 39201

CODED

WATER WELL DRILLERS LOG

April 6 1973 Abelle Water Supply Jackson
 date well completed firm name county well located


LANDOWNER: <u>Gerry Parker</u>	description of formations encountered	from	to
<u>Wade Ms</u> (mailing address)	<u>Clay</u>	<u>0</u>	<u>38</u>
WELL LOCATION: sec. <u>10</u> T. <u>5</u> N. R. <u>6</u> E <u>1 1/2</u> miles <u>South</u> of <u>Wade</u> (distance) (direction) (nearest town)	<u>sand</u>	<u>38</u>	<u>92</u>
WELL PURPOSE: <u>Domestic</u> (home, irrigation, municipal, industrial)	<u>Clay</u>	<u>92</u>	<u>363</u>
WELL COMPLETION DATA: (1) diameter (Inches) <u>2</u>	<u>sand</u>	<u>363</u>	<u>390</u>
(2) total depth (feet) <u>390</u>			
(3) static water level (feet) <u>10</u> <u>below</u> <u>above</u> top of ground.			
(4) casing <u>Galv</u> , <u>385</u> (material) (depth)			
(5) screen <u>5'</u> , <u>385</u> (length) (depth to top)			
<u>2"</u> , <u>Stainless</u> (size) (material)			
(6) pump _____ (HP) _____ (yield gpm) (type power)			
(7) electric log <u>no</u> (yes or no)			
(8) how well bottom plugged <u>BD Probe</u>			
DRILLERS REMARKS: <u> pump installed by owner</u>			

CODED

FIG. 21 1010

If well telescopes please sketch and show depths.

GROUND LEVEL

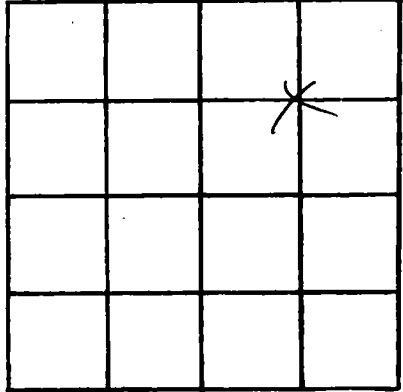

SECTION 10

Please indicate well location X.

ADDITIONAL INFORMATION

If more than one screen, show locations of each on sketch.