

JACKSON
 595
 4-5-73

MISSISSIPPI
 BOARD OF WATER COMMISSIONERS
 416 North State Street
 Jackson, Mississippi 39201

CODED

WATER WELL DRILLERS LOG

April 5 1973 Cohle Water Supply Jackson
 date well completed firm name county well located


LANDOWNER: <u>John</u>	description of formations encountered	from	to
<u>Johnson</u> <u>Wade Ms</u> (mailing address)	sand <u>sand</u> <u>clay</u> <u>adul</u>	0 <u>0</u> <u>111</u> <u>111</u> <u>145</u>	<u>111</u> <u>145</u> <u>168</u>
WELL LOCATION: sec <u>26</u> T <u>5</u> N R <u>6</u> E <u>1/2</u> miles <u>East</u> of <u>3 Rivers</u> (distance) (direction) (nearest town)			
WELL PURPOSE: <u>Home</u> (home, irrigation, municipal, industrial)			
WELL COMPLETION DATA: (1) diameter (inches) <u>2</u> (2) total depth (feet) <u>168</u> (3) static water level (feet) <u>15</u> ^{below} _{above} top of ground. (4) casing <u>galv</u> <u>163</u> (material) (depth) (size) if telescope see back. (5) screen <u>5'</u> <u>163</u> (length) (depth to top) <u>2"</u> <u>stainless</u> (size) (material) (6) pump _____ (HP) _____ (yield gpm) (type power) (7) electric log <u>no</u> (yes or no) (organization running log) (8) how well bottom plugged <u>BP valve</u>			
DRILLERS REMARKS: <u>pump installed by owner</u>			

CODED

DEC 21 1973

If well telescopes please sketch and show depths.

GROUND LEVEL

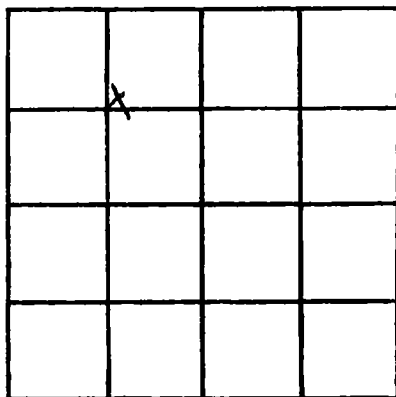

SECTION *26*

Please indicate well location X.

ADDITIONAL INFORMATION

If more than one screen, show locations of each on sketch.