

JACKSON  
G 96  
7-18-73

MISSISSIPPI  
BOARD OF WATER COMMISSIONERS  
416 North State Street  
Jackson, Mississippi 39201

CODED

WATER WELL DRILLERS LOG

July 18 1973 Colville Water Supply Jackson  
date well completed firm name county well located


LANDOWNER: <u>C. T. White</u>	description of formations encountered	from	to
<u>Wade Mrs.</u> (mailing address)	Clay	0	45
WELL LOCATION: sec. <u>3</u> T <u>S</u> N R <u>6</u> E <u>16</u> miles <u>North</u> of <u>Moss Point</u> (distance) (direction) (nearest town)	sand	45	87
WELL PURPOSE: <u>Home</u> (home, irrigation, municipal, industrial)	Clay	87	426
WELL COMPLETION DATA:	sand	426	473
(1) diameter (inches) <u>2</u>	Clay	473	557
(2) total depth (feet) <u>574</u>	sand	557	574
(3) static water level (feet) <u>5</u> <sup>below</sup> <del>above</del> top of ground.			
(4) casing <u>galv</u> <u>564</u> (material) (depth)			
(size) if telescope see back.			
(5) screen <u>10</u> <u>564</u> (length) (depth to top)			
<u>2"</u> <u>stain</u> (size) (material)			
(6) pump _____ (HP) (yield gpm)			
(type power)			
(7) electric log <u>no</u> (yes or no)			
(organization running log)			
(8) how well bottom plugged <u>BPI Valve</u>			
DRILLERS REMARKS: <u>pump installed by owner</u>			

CODED

36-21-273

If well telescopes please sketch and show depths.

GROUND LEVEL

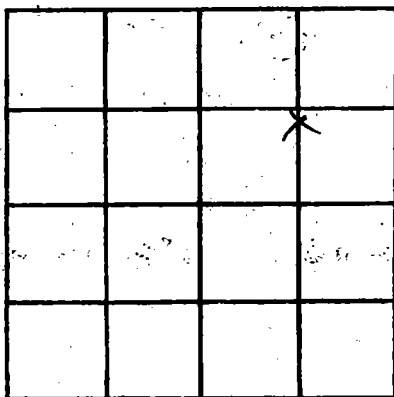

SECTION 3

Please indicate well location X.

ADDITIONAL INFORMATION

If more than one screen, show locations of each on sketch.