

JACKSON
 697
 5-23-73

MISSISSIPPI
 BOARD OF WATER COMMISSIONERS CODED
 416 North State Street
 Jackson, Mississippi 39201


WATER WELL DRILLERS LOG

May 23 1973 Calville Water Supply Jackson
 Date well completed firm name county well located

LANDOWNER: <u>Lonnie Roberts</u> <u>Three Rivers</u> (mailing address)	description of formations encountered	from	to
WELL LOCATION: sec. <u>26</u> T. <u>5</u> N. R. <u>6</u> E <u>12</u> miles <u>North</u> of <u>Miss Point</u> (distance) (direction) (nearest town)	Clay Sand Clay fine sand Clay sand	0 27 90 506 528 1132 1141	27 90 504 528 1132 1141
WELL PURPOSE: <u>Home</u> (home, irrigation, municipal, industrial)	CODED		
WELL COMPLETION DATA: (1) diameter (inches) <u>2</u> " (2) total depth (feet) <u>1141</u> (3) static water level (feet) <u>+3</u> <u>below</u> <u>above</u> top of ground. (4) casing <u>Galv</u> <u>1131</u> (material) (depth) (size) if telescope see back. (5) screen <u>10</u> <u>1131</u> (length) (depth to top) <u>2"</u> <u>Stainless</u> (size) (material) (6) pump _____ (HP) _____ (yield gpm) (type power) (7) electric log <u>No</u> (yes or no) (organization running log) (8) how well bottom plugged <u>BP Valco</u>			
DRILLERS REMARKS: <u> pump installed by owner</u>			

If well telescopes please sketch and show depths.

GROUND LEVEL

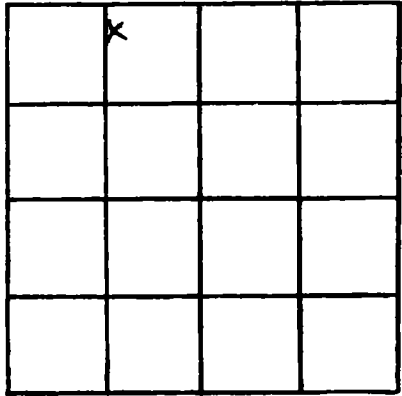

SECTION R6

Please indicate well location X.

ADDITIONAL INFORMATION

If more than one screen, show locations of each on sketch.