

JACKSON
G98
4-18-75

MISSISSIPPI
BOARD OF WATER COMMISSIONERS
416 North State Street
Jackson, Mississippi 39201

CODED

WATER WELL DRILLERS LOG

April 18, 1975 Bill W. W. Co Jackson
date well completed firm name county well located

LANDOWNER: Gary Johnson

Rt. 2 Passagoula

(mailing address)

WELL LOCATION:

sec. A T. 45 N. R. 6 E. S. 5 W.
1 miles north of Wade
(distance) (direction) (nearest town)

WELL PURPOSE: home
(home, irrigation, municipal, industrial)

WELL COMPLETION DATA:

- (1) diameter (inches) 3"
- (2) total depth (feet) 75'
- (3) static water level (feet) 14' below above top of ground.
- (4) casing PVC 70'
(material) (depth)
 If telescope see back.
(size)
- (5) screen 5' 70'
(length) (depth to top)
3" PVC
(size) (material)
- (6) pump 1 17
(HP) (yield gpm)
el.
(type power)
- (7) electric log no
(yes or no)

(organization running log)
- (8) how well bottom plugged Good

description of formations encountered

from to

description of formations encountered	from	to
<u>red clay</u>	<u>0'</u>	<u>6'</u>
<u>red clay</u>	<u>6'</u>	<u>18"</u>
<u>white sandy clay</u>	<u>18"</u>	<u>25"</u>
<u>coarse white sand</u>	<u>25"</u>	<u>50"</u>
<u>red white sand</u>	<u>50"</u>	<u>75"</u>


DRILLERS REMARKS:

RECEIVED
MAY 21 1975

MISS. BD. OF WATER COM.

If well telescopes please sketch and show depths.

GROUND LEVEL

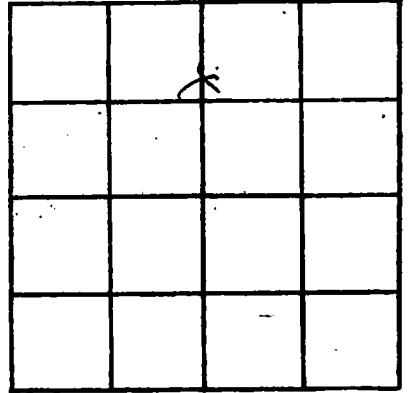

SECTION 3

Please indicate well location X.

ADDITIONAL INFORMATION

If more than one screen, show locations of each on sketch.