

MISSISSIPPI DEPARTMENT OF NATURAL RESOURCES

Bureau of Land and Water Resources

Southport Mall

P.O. Box 10631

Jackson, Mississippi 39209

WATER WELL DRILLERS LOG

CODED

JACKSON
G 101
3-23-81

3-23-81 19 Cross Water Well Serv. Inc. Jackson
date well completed firm name country well located

LANDOWNER	description of formations encountered	from	to
<u>O. E. Scarborough</u> <u>Rt 5 Box 184</u>	<u>Top soil</u>	<u>0</u>	<u>1</u>
<u>Lascayola, MS 39567</u> (mailing address)	<u>Red coarse sand and gravel</u>	<u>1'</u>	<u>170'</u>
WELL LOCATION: sec. <u>23</u> T. <u>5</u> N. R. <u>6</u> W. <u>3 1/2</u> miles <u>S</u> of <u>WADE</u> (distance) (direction) (nearest town)	<u>blue clay</u>	<u>170'</u>	<u>256'</u>
WELL PURPOSE: <u>Home</u> (home, irrigation, municipal, industrial)	<u>gray coarse sand</u>	<u>256'</u>	<u>294'</u>
WELL COMPLETION DATA: (1) diameter (inches) <u>2"</u>			
(2) total depth (feet) <u>294'</u>			
(3) static water level (feet) <u>33'</u> <u>below</u> top of ground. <u>above</u>			
(4) casing <u>PVC</u> , <u>284'</u> (material) (depth)			
<u>2"</u> (size) if telescope see back.			
(5) screen <u>10'</u> , <u>284'</u> (length) (depth to top)			
<u>2"</u> , <u>PVC</u> (size) (material)			
(6) pump <u>1 hp.</u> , <u>10 1/2</u> (HP) (yield gpm)			
<u>Elect.</u> (type power)			
(7) electric log <u>No.</u> (yes or no)			
<u></u> (organization running log)			
(8) how well bottom plugged <u>Back wash valve</u>			

DEPT. OF NATURAL RESOURCES
BUREAU OF LAND & WATER RESOURCES


APR - 9 1981

RECEIVED

DRILLERS REMARKS:

If well telescopes please sketch and show depths.

GROUND LEVEL

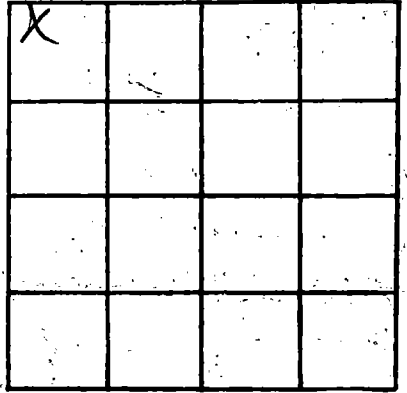

SECTION 23

Please indicate well location X.

ADDITIONAL INFORMATION

If more than one screen, show locations of each on sketch.