

MISSISSIPPI DEPARTMENT OF NATURAL RESOURCES

Bureau of Land and Water Resources

Southport Mall

P.O. Box 10631

Jackson, Mississippi 39209

WATER WELL DRILLERS LOG

JACKSON
G 109

Coded

10-20 1987 Pierce Drilling Co. Jackson
date well completed firm name county well located

LANDOWNER: <u>Barry Umheat</u>	description of formations encountered	from	to
<u>Wade, Ms</u> (mailing address)	<u>top soil</u>	<u>0</u>	<u>10</u>
	<u>Clay</u>	<u>10</u>	<u>20</u>
	<u>Sand</u>	<u>20</u>	<u>125</u>
	<u>Clay</u>	<u>125</u>	<u>330</u>
	<u>good Sand</u>	<u>330</u>	<u>350</u>

WELL LOCATION:

sec 23 T 5 N R 6 E
 (distance) (direction) (nearest town)
1 miles North of Three Rivers

WELL PURPOSE:

(home, irrigation, municipal, industrial)


WELL COMPLETION DATA:

- (1) diameter (inches) 4"
- (2) total depth (feet) 350'
- (3) static water level (feet) 30' ^{below} above top of ground.
- (4) casing plastic, 340'
(material) (depth)
- 0 If telescope see back.
(size)
- (5) screen 10', 350'
(length) (depth to top)
- 006, plastic
(size) (material)
- (6) pump 1 18
(HP) (yield gpm)
- electric
(type power)
- (7) electric log yes or no

(organization running log)

(8) how well bottom plugged BW

DRILLERS REMARKS:

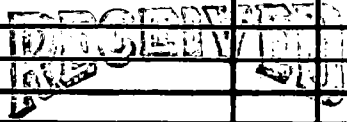


SEP 15 1987

Department of Natural Resources
Bureau of Land & Water Resources

If well telescopes please sketch and show depths.

GROUND LEVEL

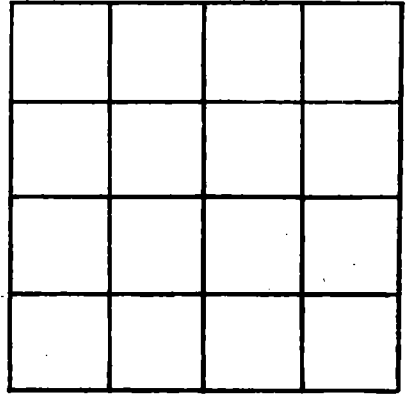

SECTION _____

Please indicate well location X.

ADDITIONAL INFORMATION

If more than one screen, show locations of each on sketch.